


CORNER No. 17

OREGON CORNER RESTORATION FORM

Section 27 Township 32S Range 7W

County Douglas Date March, 2002

Corner Designation

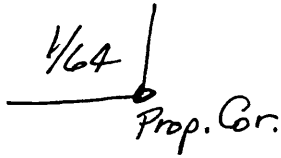

- Condition Report Only
- Not Found
- Renewed
- Unrecorded
- Surveyed In
- Referenced Out

Previous Renewals/Surveys, etc.

RLS Van Swearingen, Map 21-6d, in 1961 *


*(We were requested to redo this survey.)

Monument(s) & Accessories Found: (Condition and Source)
Set

I set a 3/4" x 40" Iron Rod with a 2 1/2" Alum. Cap, from which a:
8" Live Oak BT, I scribed "1/64 BT", bears N25° W, 10 ft.
10" D. Fir BT, I scribed "1/64 BT", bears 58° W, 29.8 feet.

6 Foot Steel Fence Post bears East, 10 foot.

Monument Detail

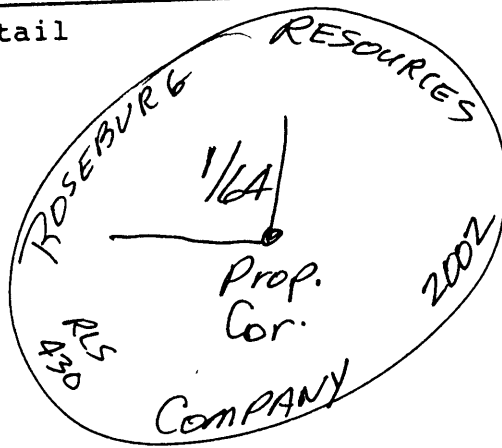

Sketch

FILED

Date: 3/27/2002 By: JC

This survey consists of:

Map: M137-35

Narrative:

Corner Rpt: 65/42-11 thru 39

DOUGLAS COUNTY
SURVEYOR

Monument Set (Procedures and Description)

New Accessories

Location & Comments

V.S. Corner
Not found.

Compass Declination 20° E

Firm/Agency Shaner
Engineering

Address P.O. Box 1430
Roseburg, OR 97470

Party Chief B. Shaner

Notes " "

Witness Ben Schneider

Surveyor's Seal

REGISTERED
PROFESSIONAL
LAND SURVEYOR

Bruce A. Shaner

OREGON
OCT. 4, 1957
BRUCE A. SHANER
430

Renews June 30,
2002

C.S. File No 65/42-27