


OREGON CORNER ~~RESTORATION~~ FORM

CORNER No. 19

Section 27 Township 32S Range TW

County Douglas Date March, 2002

Corner Designation

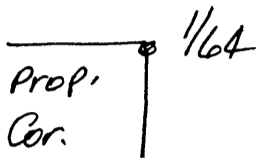

- Condition Report Only
- Not Found
- Renewed
- Unrecorded
- Surveyed In
- Referenced Out

Previous Renewals/Surveys, etc.

RLS Van Swearingen, Map M21-61, in 1961. *
*(We were requested to redo this survey.)

Monument(s) & Accessories ~~Found~~ Set (Condition and Source)

I set a 3/4" x 40" Iron Rod with a 2 1/2" Alum. Cap, from which a:
26" Pine BT, now snag, scribes "4186 BT" visible, bears
N32°W, 22 3/4 feet.

12" Cedar BT, face overgrown, bears N4°E, 20 1/4 feet.


10" Cedar BT, I scribed "1/64 BT", bears N32°E, 29 1/4 feet.

Drill Steel Corner, set by V.S., bears N31°W, 10 00 feet.

6 Foot Steel Post bears East, 12 feet.

Monument Detail

Sketch

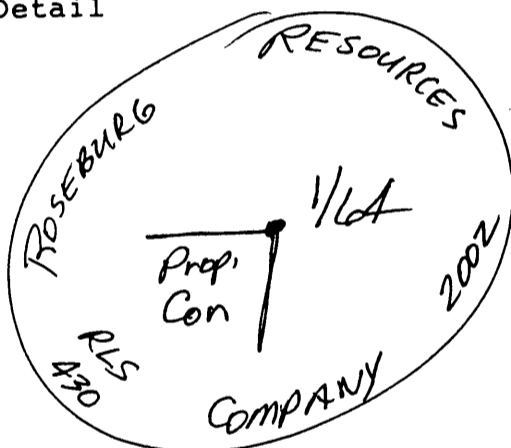

FILED

Date: 3/27/2002 By: JC

This survey consists of:

Map: M137-35

Narrative:

Corner Rpt: 65/42-11 thru 39

DOUGLAS COUNTY
SURVEYOR

Monument Set (Procedures and Description)

New Accessories

Location & Comments

Compass Declination 20°E

Firm/Agency Shaner Engineering

Address P.O. Box 1430 Roseburg, OR 97470

Party Chief B. Shaner

Notes " "

Witness Ron Schneider

Surveyor's Seal

REGISTERED
PROFESSIONAL
LAND SURVEYOR

Bruce A. Shaner

OREGON
OCT. 4, 1957
BRUCE A. SHANER
430

Renews June 30, 2002

C.S. File No. 65/42-29