


OREGON CORNER RESTORATION FORM

CORNER NO. 21

Section 27 Township 32S Range 7W

County Douglas Date March, 2002

Corner Designation

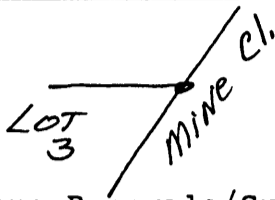

- Condition Report Only
- Not Found
- Renewed
- Unrecorded
- Surveyed In
- Referenced Out


Previous Renewals/Surveys, etc. _____

None.

Monument(s) & Accessories ^{Set 2} Found: (Condition and Source)

I set a 3/4" x 40" Iron Rod with a 2 1/2" Alum. Cap, from which a:
34" D. Fir BT, I scribed "PCBT" bears 562°E, 6⁰ feet
44" D. Fir BT, I scribed "PCBT" bears 576°W, 10³ feet.
6 Foot Steel Fence Post bears West, 1⁰ feet.

Monument Detail

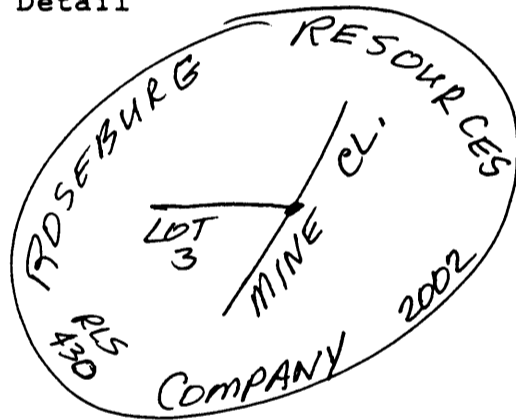

Sketch

FILED

Date: 3/27/2002 By: JK
 This survey consists of:
 Map: M 137-35
 Narrative: _____
 Corner Rpt: 65/42-1170 r 39

DOUGLAS COUNTY SURVEYOR

Monument Set (Procedures and Description)

New Accessories

Location & Comments

Compass Declination 20°E
 Firm/Agency Shaner Engineering
 Address P.O. Box 1430 Roseburg, OR 97470
 Party Chief B. Shaner
 Notes " "
 Witness Ron Schneider

Surveyor's Seal

REGISTERED
 PROFESSIONAL
 LAND SURVEYOR

Bruce A Shaner

OREGON
 OCT. 4, 1957
 BRUCE A. SHANER
 430

Renews June 30,

C.S. File No 65/42-31 2002