

FILED

Date: 3-28-2002 By: JC

This survey consists of:

Map: M139-61

Narrative: \_\_\_\_\_

Corner Rpt: 65/42-40B


OREGON CORNER RESTORATION FORM

Section 18 Township 31S Range 4W

County Douglas Date March 27, 2002

DOUGLAS COUNTY SURVEYOR

Corner Designation

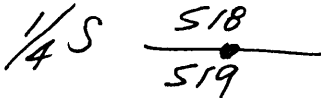

- Condition Report Only
- Not Found
- Renewed
- Unrecorded
- Surveyed In
- Referenced Out

Previous Renewals/Surveys, etc.

Douglas County Surveyors Office (Marraan), CS File 61/19, 1981

Monument(s) & Accessories Found: (Condition and Source)

Found Douglas Co. Surveyor 2 1/2" Brass Cap in large mound of stone, from which a:

24" Cedar BT, face overgrown, bears N68°E, 22° feet.

14" Cedar BT, " " , bears N40°W, 17° feet.

22" D. Fir BT, high stump only, bears N6°E (Record N 1 1/2°E),


12" Cedar BT, scribes "BT" visible, ← 39° feet.

Now only a stump, bears S61 1/2°E, 117° feet.

6 Foot Steel Fence post bears West, 1° feet.

Monument Detail

Sketch

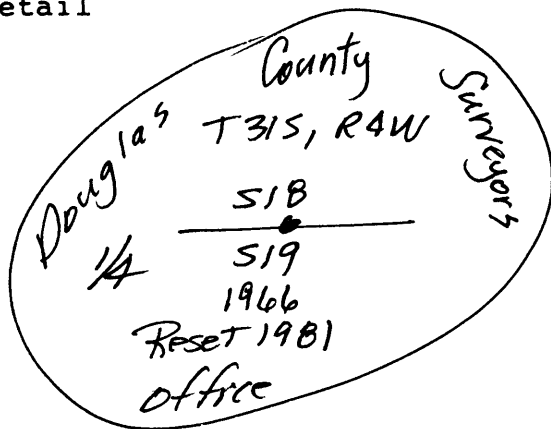

Monument Set (Procedures and Description)

N/A

New Accessories

22" D. Fir BT, I scribed "1/4 S19 BT" bears S35°E, 78° feet.

Location & Comments

Corner is in cutbank, North side of a main rocky road.

Compass Declination 20°E  
 Firm/Agency Shaner Engineering, Inc  
 Address P.O. Box 1430 Roseburg, Oregon 97470  
 Party Chief B. Shaner  
 Notes " "  
 Witness Tom Schneider

Surveyor's Seal

REGISTERED PROFESSIONAL LAND SURVEYOR

Bruce A Shaner

OREGON OCT. 4, 1957 BRUCE A. SHANER 430

Renews June 30, 2002

C.S. File No. 65/42-40 B