

FILED

Date: 3-28-2002 By: JC

This survey consists of:

Map: M 139-61

Narrative: \_\_\_\_\_

Corner Rpt: 65/42-400


OREGON CORNER RESTORATION FORM

Section 18 Township 31S Range 4W

DOUGLAS COUNTY  
SURVEYOR

County Douglas Date March 27, 2002

Corner Designation

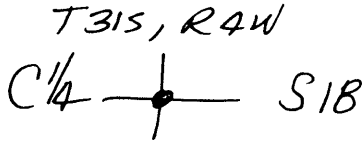

- Condition Report Only
- Not Found
- Renewed
- Unrecorded
- Surveyed In
- Referenced Out

Previous Renewals/Surveys, etc. \_\_\_\_\_

Survey by Robert M. Thompson, Map M15-24, 1959.

Monument(s) & Accessories Found: (Condition and Source)


Found 1" Iron Pipe, from which a:

26" D. Fir BT, faces overgrown, bears N10 1/2° W, 365 feet.

10" D. Fir BT, Now Gone, bears N78 1/2° E, 9 ± feet.

Monument Detail

Sketch

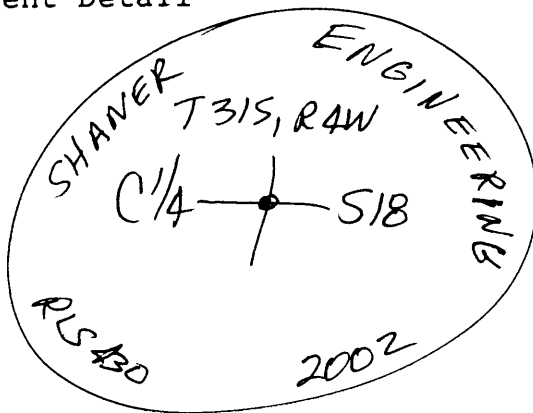

Monument Set (Procedures and Description)

In Position of 1" Iron Pipe, I set a 2 1/2" x 30" Alum. Pipe with a 3 1/4" Alum. Cap, from which a:

16" W. Fir BT, I scribed "C 1/4 S18 BT" bears S16° W, 58 feet.

6 Foot Steel Fence Post, bears North, 10 feet.

New Accessories

1" Iron Pipe by Thompson, I reset South, 03 feet.

Location & Comments

Surveyor's Seal

Compass Declination 20° E

Firm/Agency Shaner

Engineering, Inc.

Address P.O. Box 1430

Roseburg, OR 97470

Party Chief B. Shaner

Notes " "

Witness Ben Schneider

REGISTERED  
PROFESSIONAL  
LAND SURVEYOR

Bruce A Shaner

OREGON  
OCT. 4, 1957  
BRUCE A. SHANER  
430

Renewed June 30, 2002

C.S. File No 65/42-400