

FILED

Date: 3/28/2002 By: X

This survey consists of:

Map: M139-61

Name: _____

Corner Rpt: 65/42-40D

OREGON CORNER RESTORATION FORM


Section 18 Township 31S Range 4W

County Douglas Date March 27,

Corner Designation 2002

DOUGLAS COUNTY
SURVEYOR

- Condition Report Only
- Not Found
- Renewed
- Unrecorded
- Surveyed In
- Referenced Out

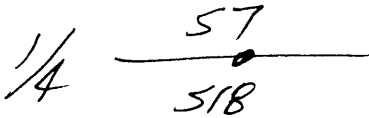

Previous Renewals/Surveys, etc.

Douglas County Surveyors Office, CS 54/20, 1966, who
renewed Thompson's Survey, Map 15-24, of 1959.


Monument(s) & Accessories Found: (Condition and Source)

I found a 2" Brass Cap on a 1" Iron Pipe, from which a:
30" D. Fir BT, face overgrown, bears S64°W (record S74°W),
18" D. Fir BT, now high stump, face overgrown,
with USBLM TIN Cap, bears N40°E (record N45 1/2°E),

Quartz Stone alongside B.C.
6 foot Steel Fence Post bears South, 05 feet.

Monument Detail

Sketch

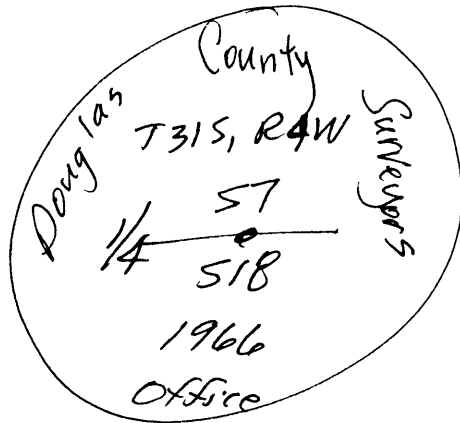

Monument Set (Procedures and Description)

N/A

New Accessories

8" W. Fir BT, inscribed "1/4 57 BT" bears
N21°W, 13 3/4 Feet.

Location & Comments

Corner is located
on E-W cutting
line of BLM
sale unit (Unit
in Section T)

Compass Declination 20°E
 Firm/Agency Shaner
Engineering, Inc
 Address P.O. Box 1430,
Roseburg Oregon 97470
 Party Chief B. Shaner
 Notes " "
 Witness Ken Schneider

Surveyor's Seal

REGISTERED
PROFESSIONAL
LAND SURVEYOR

Bruce A. Shaner

OREGON
OCT. 4, 1957
BRUCE A. SHANER
490

Renews June 30, 2002

C.S. File No 65/42-400