

FILED

Date: 4/9/2002 By: JC

This survey consists of:

Map: M139-70

Narrative: _____

Corner Rpt: 65/42-41

OREGON CORNER RESTORATION FORM

Section 30 Township 31 Range 07

County DOUGLAS Date 01/2002

DOUGLAS COUNTY
SURVEYOR

Corner Designation

100290

- Condition Report Only
- Not Found
- Renewed
- Unrecorded
- Surveyed In
- Referenced Out


Previous Renewals/Surveys, etc. _____

Monument(s) & Accessories Found: (Condition and Source)

1882	48" FIR	S25W	30 ⁴	GOOD HEALED
1882	32" FIR STUMP	S89E	26 ⁴	STUMP
1966	19" FIR	N55 1/2 W	26 ⁰	GOOD HEALED
1966	10" FIR	S63E	36 ⁵	GONE

1966 DCSO 1PBC - 1/4 CORNER

Monument Detail

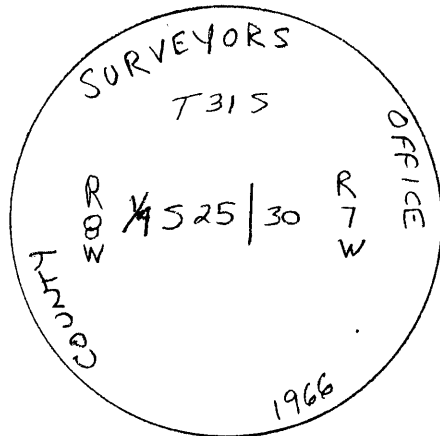

Sketch

Monument Set (Procedures and Description)


New Accessories

2001	9" FIR	N86E	21 ⁸	" 1/4 S BT "
2001	16" FIR	N49E	32 ⁹	" 1/4 S BT "

Location & Comments

Compass Declination _____
 Firm/Agency ROSEBURG FOREST PRODUCTS I
 Address PO BOX 1088
ROSEBURG, OR 97470
 Party Chief BILL OLSON
 Notes _____
 Witness BRET ALFORD

Surveyor's Seal

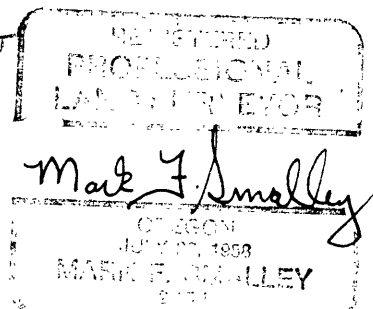

RENEWS 6/30/02

C.S. File No. 65/42-41