

FILED

Date: 4-15-2002 By: SC

This survey consists of:

Map: M139-72

Narrative:

Corner Rpt: 65/42-42 A-D

OREGON CORNER RESTORATION FORM

Section 36 Township 30S Range 8W

County Douglas Date Apr. 11, 2002

DOUGLAS COUNTY
SURVEYOR

Corner Designation

- Condition Report Only
- Not Found
- Renewed
- Unrecorded
- Surveyed In
- Referenced Out

Previous Renewals/Surveys, etc.

U.S.G.L.O., 1918, Surveyor Sorrels.


Howard Johnstone, " ", 1984 Survey.

Monument(s) & Accessories Found: (Condition and Source)

Found 1" Iron pipe with 2 1/2" Brass Cap, from which a:
11" Madrone BT, now snag, face overgrown, bears S14 1/2° E, 17 1/2 ft.
16" D. Fir BT, face overgrown, bears S85° E, 26 1/2 feet.
8" D. Fir BT, now dead & down, bears S82° W, 18 1/2 feet.

Monument Detail

Sketch

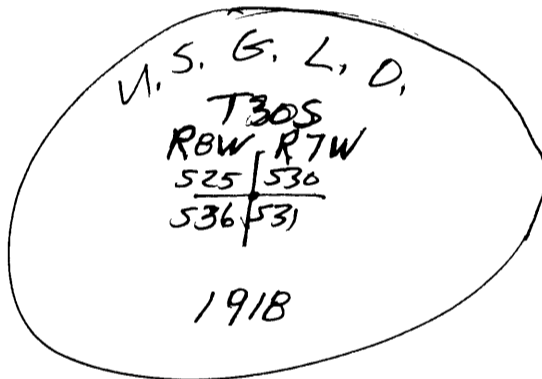

Monument Set (Procedures and Description)

None.

New Accessories

22" D. Fir BT, I scribed "T30S, R8W, 536, BT",
bears S79° W, 62 1/2 feet.

16" D. Fir BT, I scribed "T30S, R7W, 530, BT",
bears N59° E, 22 1/2 feet.

6 Feet Steel Post bears East, 10 feet.

Location & Comments

Corner is West,
30 feet from small
intermittent stream,
flows S20° E.

Compass Declination 20° E

Firm/Agency Shaner
Engineering, Inc.

Address P.O. Box 1430
Roseburg, OR 97470

Party Chief B. Shaner

Notes " "

Witness Ken Schneider

Surveyor's Seal

REGISTERED
PROFESSIONAL
LAND SURVEYOR

Bruce A Shaner

OREGON
OCT. 4, 1957
BRUCE A. SHANER
430

Renews June 30,
2002

C.S. File No 65/42-42 B