

FILED

Date: 4-15-2002 By: J

This survey consists of:

Map: M 139-72

Narrative: _____

Corner Rpt: 65/42-42 A-D

OREGON CORNER RESTORATION FORM

Section 36 Township 30S Range BW

County Douglas Date April 15 2002

DOUGLAS COUNTY
SURVEYOR

Corner Designation

1/4
536 | 531

- Condition Report Only
- Not Found
- Renewed
- Unrecorded
- Surveyed In
- Referenced Out

Previous Renewals/Surveys, etc. _____

U.S.G.L.O., Surveyor Sorrels, 1918.


Douglas Co. Surveyor, James Byron, 1964, C.S. File 53/40.

Monument(s) & Accessories Found: (Condition and Source)

Found 1" Iron Pipe with 2 1/2" Brass Cap, from which a;
18" D. Fir BT, now stump, face overgrown, bears 58 1/2° W,
20" Yew BT, bears 531° E, 33° feet. (Now gone) 23 1/2 feet. ↘
30" D. Fir BT, face overgrown, bears N 71° E, 15° feet.

Monument Detail

Sketch

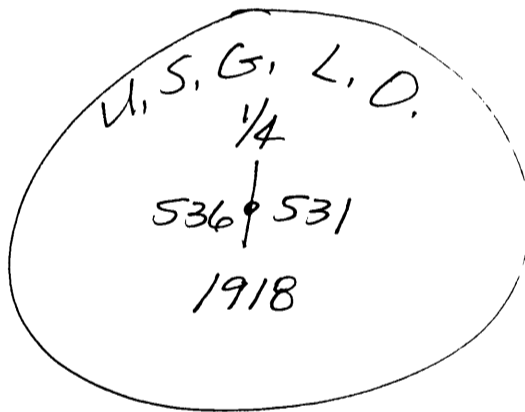

Monument Set (Procedures and Description)

None.

New Accessories

10" W. Fir BT, I scribed " 1/4 536 BT "
bears N 35° W, 28 3/4 feet.

6 foot steel fence post bears East, 1° foot.

Location & Comments

Corner lies South
a distance of
100 feet from
Table Creek.

Compass Declination 20° E

Firm/Agency Shaner

Engineering, Inc.

Address P.O. Box 1430
Roseburg, Oregon 97470

Party Chief B. Shaner

Notes " "

Witness Ron Schneider

Surveyor's Seal

REGISTERED
 PROFESSIONAL
 LAND SURVEYOR

Bruce A Shaner

OREGON
 OCT. 4, 1957
 BRUCE A. SHANER
 430

Renews June 30, 2002

C.S. File No. 65/42-42C