

FILED

Date: 4-15-2002 By: JC

This survey consists of:

Map: M 139-72

Narrative

Corner Rpt: 65/42-42 A-C

OREGON CORNER RESTORATION FORM

Section 36 Township 30S Range 8W

County Douglas Date April 11, 2002

DOUGLAS COUNTY
SURVEYOR

Corner Designation

W 1/16 525
 •
 536

- Condition Report Only
- Not Found
- Renewed
- Unrecorded
- Surveyed In
- Referenced Out

Previous Renewals/Surveys, etc.


U.S.B.L.M. Survey in Section 25, in 1985.

Monument(s) & Accessories Found: (Condition and Source)

Found 2 1/2" Iron Pipe with 3/4" Brass Cap, from which a:
10" D. Fir BT, face overgrown, bears S 21° E, 21^B feet.
8" D. Fir BT, " " , bears N 60° W, 13⁹ feet.

Monument Detail

Sketch

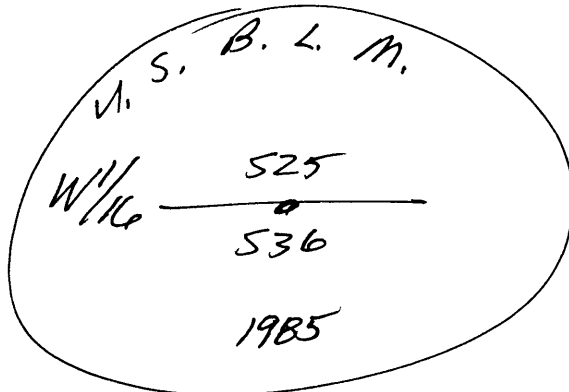

Monument Set (Procedures and Description)

None

New Accessories

Set 6 foot Steel Fence Post East, 1⁰ feet.

Location & Comments

Corner is located
North a distance
of 32⁰ feet from
old logging road
that runs E-W.

Compass Declination 20°E

Firm/Agency Shaner

Engineering, Inc.

Address P.O. Box 1430

Roseburg, Oregon 97470

Party Chief B. Shaner

Notes " "

Witness Rev Schneider

Surveyor's Seal

REGISTERED
PROFESSIONAL
LAND SURVEYOR

Bruce A Shaner

OREGON
OCT. 4, 1957
BRUCE A. SHANER
430

Renews June 30,
2002