

FILED

Date: 8/13/2002 By: JC

This survey consists of:

Map _____

Name _____

Corner 65/44-9

DOUGLAS COUNTY
SURVEYOR

OREGON CORNER RESTORATION FORM

Section 35 Township 24S Range 6W

County DOUGLAS Date 7/30/02

Corner Designation

W 1/4 SEC 35 T24S R6W

- Condition Report Only
- Not Found
- Renewed
- Unrecorded
- Surveyed In
- Referenced Out

Previous Renewals/Surveys, etc. _____

500140

Monument(s) & Accessories Found: (Condition and Source)

<u>5/8" I.R.</u>			<u>GOOD</u>
<u>26" FIR STUMP</u>	<u>N52°30'E</u>	<u>53° H.</u>	<u>ROTTED - NO MARKS REMAINING</u>
<u>16" W. OAK</u>	<u>S60°E</u>	<u>44° H.</u>	<u>GOOD</u>

Monument Detail

Sketch

Monument Set (Procedures and Description)

New Accessories

NEW BEARING TREES

<u>23" DOUGLAS FIR BEARS DUE EAST</u>	<u>45°</u>	<u>SCRIBED</u>	<u>" 1/4 S35 BT "</u>
<u>9" DOUGLAS FIR</u>	<u>" S16°E</u>	<u>49°</u>	<u>" " 1/4 S35 BT "</u>
<u>6" DOUGLAS FIR</u>	<u>" N85°W</u>	<u>35°</u>	<u>" " 1/4 S34 BT "</u>

Location & Comments

Compass Declination 18°

Firm/Agency ROSEBURG

FOREST PRODUCTS

Address Hwy. 99S


DILLARD, OR

Party Chief R. McMANIS

Notes _____

Witness _____

Surveyor's Seal

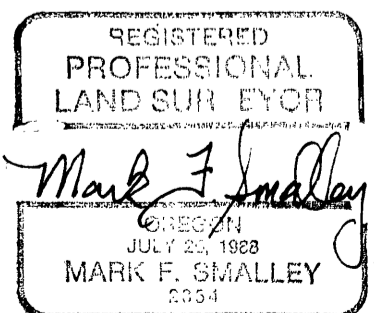

Renews 6/30/04

C.S. File No 65/44-9