

FILED

Date: 8/23-2002 By: X

This survey consists of:

Map: _____

Narrative: _____

Corner Rpt: 65/44-11

OREGON CORNER RESTORATION FORM

Section 24 Township 31S Range 8W

County DOUGLAS Date 5-31-02

DOUGLAS COUNTY
SURVEYOR

Corner Designation

N 1/4 Cor S13
S24

- Condition Report Only
- Not Found
- Renewed
- Unrecorded
- Surveyed In
- Referenced Out

Previous Renewals/Surveys, etc. _____

Monument(s) & Accessories Found: (Condition and Source)

1977 BLM IPBC

17" FIR N6 1/2 E 58 1/2 LKS (38.6") GOOD CONDITION - HEALED FACE

FOUND UNRECORDED


13" FIR WITH HEALED FACE, 1/4 PWT

A ROSEBURG FOREST PRODUCTS BT TAG WITH INFORMATION.

13" FIR WEST 21 S GOOD CONDITION - HEALED FACE

Monument Detail

Sketch

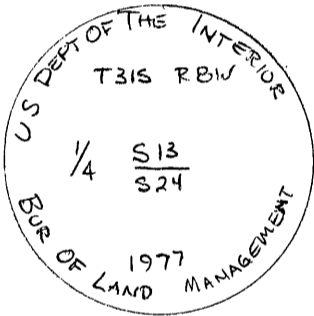

Monument Set (Procedures and Description)

New Accessories

2001 9" FIR S1E 16.1" SCRIBED "1/4 S BT"

2001 8" FIR N32W 6.6" SCRIBED "1/4 S BT"

Location & Comments

Surveyor's Seal

Compass Declination 19 1/2

Firm/Agency Roseburg Forest Products


Address PO Box 1088

Roseburg Or. 97470

Party Chief Bill Olson

Notes Mike Fromdahl

Witness _____

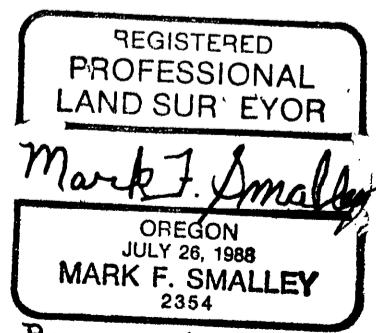

RENEWS 6/30/04

C.S. File No 65/44-11