

FILED

Date: 8/13/2002 By: JS

This survey consists of:

Map: _____

Narrative: _____

Corner Rpt: 65/44-12

OREGON CORNER RESTORATION FORM

Section 24 Township 31S Range 8W

County DOUGLAS Date 5-31-02

DOUGLAS COUNTY SURVEYOR

Corner Designation

W 1/4 CORNER

- Condition Report Only
- Not Found
- Renewed
- Unrecorded
- Surveyed In
- Referenced Out

Previous Renewals/Surveys, etc. _____

Monument(s) & Accessories Found: (Condition and Source)


1977 BLM IPBC

7" FIR N77 1/2 E 14.5 Lks (9.6') GOOD - HEALED FACE

11" FIR N89 W 8.0 Lks (5.3') GOOD - HEALED FACE

Monument Detail

Sketch

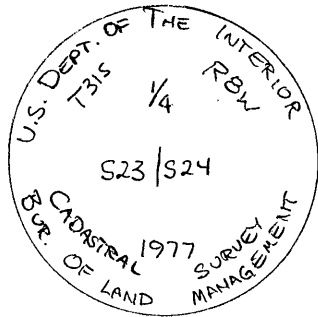

Monument Set (Procedures and Description)

New Accessories


2002 10" FIR S71E 17.2' SCRIBED "1/4 S BT"

2002 7" FIR N18W 28.8' SCRIBED "1/4 S BT"

Location & Comments

Compass Declination 19 1/2
 Firm/Agency Roseburg Forest
 Products 1
 Address PO Box 1088
Roseburg Or 97470
 Party Chief Bill Olson
 Notes Mike Fromdahl
 Witness _____

Surveyor's Seal

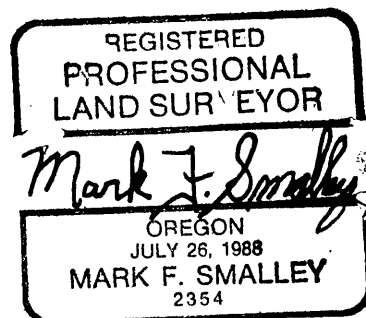

Renews 6/3/04

C.S. File No 65/44-12