

FILED

Date: 8/13/2002 By: J

This survey consists of:

Map: _____

Natural: _____

Corner Rpt: 65/44-13

OREGON CORNER RESTORATION FORM

Section 24 Township 31S Range 8W

County DOUGLAS Date 5-31-02

DOUGLAS COUNTY SURVEYOR

Corner Designation

S.W. SEC COR

- Condition Report Only
- Not Found
- Renewed
- Unrecorded
- Surveyed In
- Referenced Out

Previous Renewals/Surveys, etc. _____

COUNTY RENEWAL #41

Monument(s) & Accessories Found: (Condition and Source)


1967 DCSO IPBC

ORIG. 28" FIR N24W 25.7' GOOD-HEALED FACE

ORIG. 12" MAPLE S65E 23.1'(SLOPE DIST) FAIR - PARTIALLY HEALED FACE

Monument Detail

Sketch

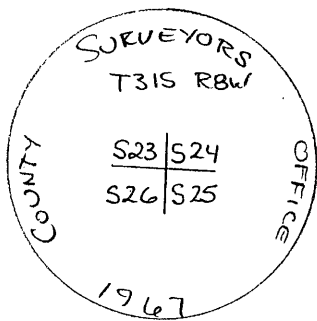

Monument Set (Procedures and Description)

New Accessories

2001 36" FIR S78E 27.3' BARK SCRIBE "S25 BT"

2001 38" FIR S37E 26.8' BARK SCRIBE "S25 BT"

2001 42" FIR STUMP S53W 17.5' NO SCRIBE - TAG NAILED TO STUMP

Location & Comments

Surveyor's Seal

Compass Declination 19 1/2

Firm/Agency Roseburg Forest

Products _____


Address P.O. Box 1088

Roseburg Or 97470

Party Chief Bill Olson

Notes Mike Fromdahl

Witness _____

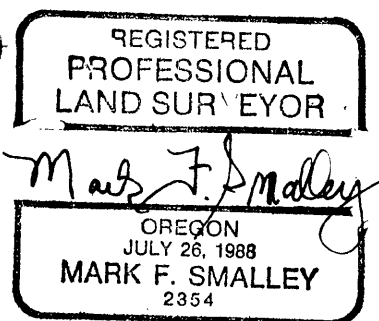

Renews 6/30/04

C.S. No 65/44-13