

OREGON CORNER RESTORATION FORM

Section 16 Township 32S Range 1W

County DOUGLAS Date 10-4-02

Corner Designation
SW SEC COR

FILED
Date: 10/18/2002 By: X
This survey consists of:
Map:
M:
Corner: 65/44-19

DOUGLAS COUNTY
SURVEYOR

- Condition Report Only
- Not Found
- Renewed
- Unrecorded
- Surveyed In
- Referenced Out

Previous Renewals/Surveys, etc. _____

Monument(s) & Accessories Found: (Condition and Source)

IRON PIPE BRASS CAP & NATIONAL FOREST POST SIGN

10" FIR SNAG N19E 9° (15' TALL) HEALED FACE

8" CEDAR SNAG N79W 38° (8' TALL) SCRIBE VISIBLE

15" FIR POSTWAD S72W 44°

6" FIR S53E 30° GONE-W CLEAR CUT

Monument Detail

Sketch

Monument Set (Procedures and Description)

New Accessories

15" FIR S30E 10° SCRIBED "S 21 BT"

13" FIR N69E 19° SCRIBED "S 16 BT"

6" FIR N10W 20° SCRIBED "S 17 BT"

2 1/2" FIR S16W NO SCRIBE TAG ONLY

Location & Comments

Compass Declination 19 1/2°

Firm/Agency ROSEBURG

FOREST PRODUCTS

Address PO Box 1088


ROSEBURG OREGON 97470

Party Chief BILL OLSON

Notes _____

Witness MIKE FROMDAHL

Surveyor's Seal

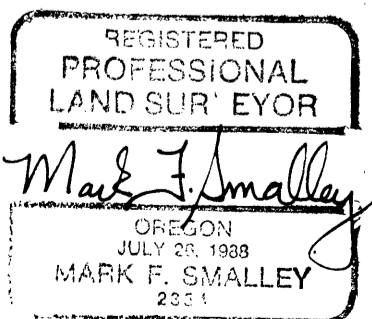

RENEWS 6/30/04

C.S. File No 65/44-19