

FILED

Date: 11/12/2002 By: JP

This survey consists of:

Map: \_\_\_\_\_

Narrative: \_\_\_\_\_

Corner Rpt: CS 65/44-22

DOUGLAS COUNTY  
SURVEYOR

OREGON CORNER RESTORATION FORM

Section 21/28 Township 21 S Range 8 W

County Douglas Date 10-25-02

Corner Designation

- Condition Report Only
- Not Found
- Renewed
- Unrecorded
- Surveyed In
- Referenced Out

Previous Renewals/Surveys, etc. \_\_\_\_\_

Monument(s) & Accessories Found: (Condition and Source)

FND: 2 1/2" GLO Brass Cap with the following

10" Douglas Fir bears N6°W, 9°ft healed face

12" Douglas Fir bears S20°W, 7°ft healed face

Monument Detail

Sketch

1/4 S21  
S28  
1945

Monument Set (Procedures and Description)

New Accessories


10" Douglas Fir bears S16°E 4<sup>7</sup>ft (Scribed 1/4 S28 BT)

12" Douglas Fir bears N25°E 3<sup>3</sup>ft (Scribed 1/4 S21 BT)

Location & Comments

Surveyor's Seal

Compass Declination \_\_\_\_\_  
 Firm/Agency Ward North West Inc.  
 Address P.O. Box 105  
Florence OR  
 Party Chief \_\_\_\_\_  
 Notes \_\_\_\_\_  
 Witness Ben Pastor

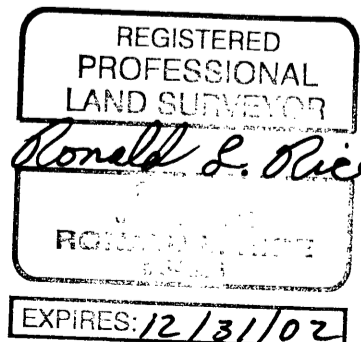

C.S. File No 65/44-22