

FILED

Date: 11/12/2002 By: JP

This survey consists of:

Map: _____

Narrative: _____

Corner Rpt: CS 65/44-23

DOUGLAS COUNTY
SURVEYOR

OREGON CORNER RESTORATION FORM

Section 21/22 Township 21 S Range 8 W

County Douglas Date 10-25-02

Corner Designation

- Condition Report Only
- Not Found
- Renewed
- Unrecorded
- Surveyed In
- Referenced Out

Previous Renewals/Surveys, etc. _____

Monument(s) & Accessories Found: (Condition and Source)

FND: 2-1/2" GLD Brass Cap with the following

48" x 4' Cedar Stump bears S62°W, 11² ft (no visible scribing) Record S46°W 18/ks

22" Cedar is missing

Monument Detail

Sketch

$\frac{1}{4}$
 S21 | S22
 1945

Monument Set (Procedures and Description)

New Accessories

- 25" Douglas Fir bears N18°W 12°ft (scribed 1/4 S21 BT)
- 11" Alder bears N56°E 9²ft (bark scribed 1/4 S22 BT)
- 12" Alder bears S66°E 2⁵ft (bark scribed 1/4 S22 BT)
- 16" Alder bears S45°E 19⁵ft (bark scribed 1/4 S22 BT)

Location & Comments

_____ Compass Declination _____

_____ Firm/Agency _____

_____ Ward North West Inc.

_____ Address P.O. Box 105


_____ Florence OR

_____ Party Chief _____

_____ Notes _____

_____ Witness Ben Pastor

Surveyor's Seal

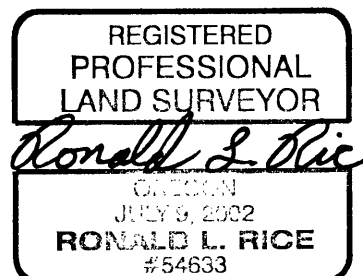

EXPIRES: 12/31/02

C.S. File No 65/44-23