

FILED

Date: 6/21/2002 By: JP

This survey consists of:

Map: M 137-44

Narrative: \_\_\_\_\_

Corner Rpt: CS 65/44-6 E

OREGON CORNER RESTORATION FORM

Section 14 Township 30S Range 6W

County Douglas Date June 19, '02

DOUGLAS COUNTY  
SURVEYOR

Corner Designation

NW 1/16  
+  
514

- Condition Report Only
- Not Found
- Renewed
- Unrecorded
- Surveyed In
- Referenced Out

Previous Renewals/Surveys, etc. \_\_\_\_\_


None

Monument(s) & Accessories Found: (Condition and Source)

\_\_\_\_\_  
 \_\_\_\_\_  
Monument Detail

Sketch

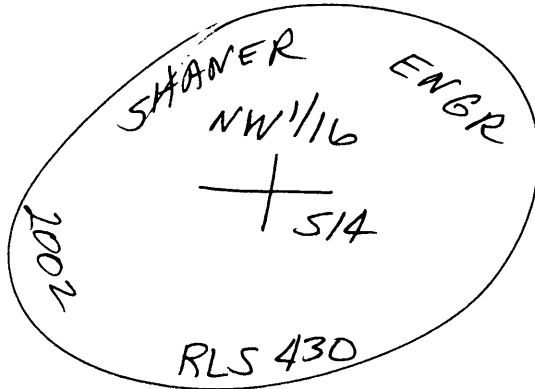

Monument Set (Procedures and Description)

I set a 5/8" x 30" Iron Rod with a 1 1/2" Alum. Cap  
from which a:



\* 5/8" Iron Rod, I placed alongside corner. This was  
set by Mason in 1981 & was found S50°W, 2 1/2 feet from corner.  
New Accessories

NE Corner of old Cattle Barn bears S43°W, 639 feet.  
Fence Corner Post, Treated with Preservative, bears S18°E,  
497 feet. Fence bears North, South & East from Fence Corner  
6 Foot Steel Fence Post bears North, 10 feet.  
" " " " " " South, 10 feet.

Location & Comments

Surveyor's Seal

Corner lies 110 feet Compass Declination 20°  
South of Stream & Firm/Agency Shaner Engineering  
Stream is 40 feet Inc.  
Wide & bears East. Address P.O. Box 1430  
Boseburg, OR 97470  
 Party Chief B. Shaner  
 Notes " "  
 Witness C. Dan Skine

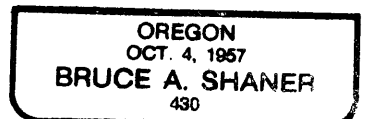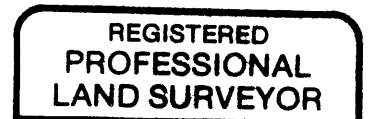

C.S. File No 65/44-6 E

Renews June 30, '04