

FILED

Date: 6/21/2002 By: JP

This survey consists of:

Map: M137-44

Narrative: _____

Corner Rpt: CS 65/44-6 F

OREGON CORNER RESTORATION FORM

Section 14 Township 30S Range 6W

County Douglas Date April, 2002

DOUGLAS COUNTY SURVEYOR

Corner Designation

$\frac{1}{4}$ $\frac{514}{523}$

- Condition Report Only
- Not Found
- Renewed
- Unrecorded
- Surveyed In
- Referenced Out

Previous Renewals/Surveys, etc.

Douglas County Surveyor Ben Irving, C.S. File 16/55 in 1939.


Mark Smalley, PLS, C.S. File 63/161-26, in 1995.

Monument(s) & Accessories Found: (Condition and Source)

Found 1/2" Iron Pipe at fence corner, from which a:
28" Black Oak BT, face overgrown, bears N49°W, 50° feet.
24" White Oak BT, scribes visible, bears S79°E, 34° feet.
11" Madrone BT, scribes visible, bears N38°E, 155 feet.
11" Madrone BT, " " , bears S53°E, 234 feet.

Monument Detail

Sketch

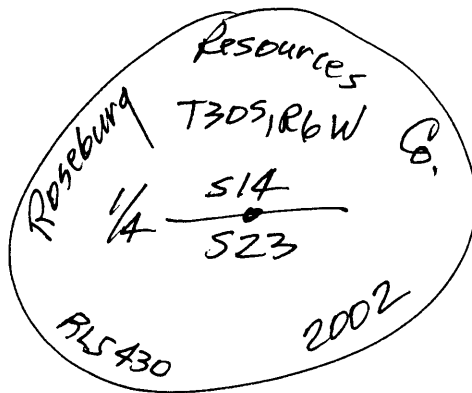

Monument Set (Procedures and Description)

I set a 3/4" x 40" Iron Rod with a 2 1/2" Alum. Cap over the 1/2" Iron Pipe, marked as above.

New Accessories

6 Foot Steel Fence Post bears North, 1° foot.

Location & Comments

1/4 S Corner is at
old fence corner.
Fence bears
North & East
from fence
corner.

Compass Declination 20°E
 Firm/Agency Shaner
Engineering, Inc.
 Address P.O. Box 1430
Roseburg, Oregon 97470
 Party Chief B. Shaner
 Notes " "
 Witness Ron Schneider

Surveyor's Seal

REGISTERED
 PROFESSIONAL
 LAND SURVEYOR

Bruce A Shaner

OREGON
 OCT. 4, 1957
 BRUCE A. SHANER
 430

C.S. File No 65/44-6 F

Renews June 30,
2002