

FILED

Date: 6/21/2002 By: JP
This survey consists of:
Map: M137-44
Narrative: _____
Corner Rpt: CS65/44-6H

OREGON CORNER RESTORATION FORM

Section 14 Township 30S Range 6W

County Douglas Date April, 2002

DOUGLAS COUNTY
SURVEYOR

Corner Designation

$\frac{1}{4}$ $\frac{S11}{S14}$

- Condition Report Only
- Not Found
- Renewed
- Unrecorded
- Surveyed In
- Referenced Out

Previous Renewals/Surveys, etc.

Douglas Co. Surveyor James Byron, C.S. File 53/26, in 1963.


Robert Mason, PLS, C.S. File 58/255, in 1981. §45BLM, 1991.

Monument(s) & Accessories Found: (Condition and Source)

Found 1" Iron Pipe with 2 1/2" Brass Cap, from which a:
42" White Oak BT, face overgrown, bears S41 1/2° W,
155.0 feet.
48" White Oak BT, " " , now blown down,
bears N41 1/2° W, 248.1 feet. (This was an original BT.)

Monument Detail

Sketch

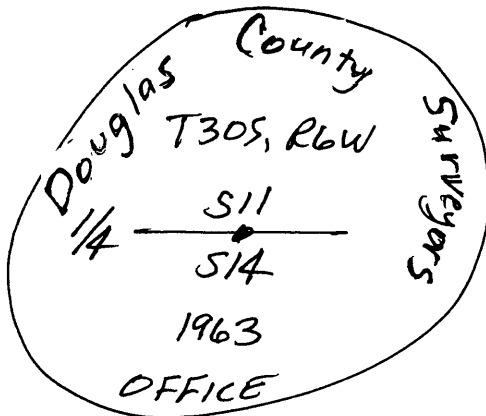

Monument Set (Procedures and Description)

N/A.

New Accessories

No Bearing Trees within reasonable distance in Sec. 11,
6 Foot Steel Fence Post bears North, 10 feet.
" " " " " " West, 10 feet.

Location & Comments

Corner lies North Compass Declination 20°E
12 feet & West 2 feet Firm/Agency Shaner
from Fence Corner. Engineering, Inc.
Fence runs North Address P.O. Box 1430
& West from fence Roseburg, Oregon 97470
Corner. Party Chief B. Shaner
Notes " "
Witness Bob Schneider

Surveyor's Seal

REGISTERED
PROFESSIONAL
LAND SURVEYOR

Bruce A. Shaner

OREGON
OCT. 4, 1957
BRUCE A. SHANER
430

Renewed June 30,
2002

C.S. File No 65/44-6H