

FILED

Date: 4/21/2002 By: JP

This survey consists of:

Map: M 137-44

Narrative: \_\_\_\_\_

Corner Rpt: CS 65/44-6 M


OREGON CORNER RESTORATION FORM

Section 14 Township 30S Range 6W

DOUGLAS COUNTY  
SURVEYOR

County Douglas Date April, 2002

Corner Designation

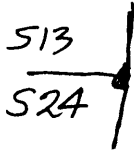

- Condition Report Only
- Not Found
- Renewed
- Unrecorded
- Surveyed In
- Referenced Out

Previous Renewals/Surveys, etc. \_\_\_\_\_

John Markham, Jr., C.S. File 41/113 in 1953.

Monument(s) & Accessories Found: (Condition and Source)

1/2" Iron Pipe by Markham not found, but set a 3/4" x 40" Iron Rod with 2 1/2" Alum. Cap, from which a:


36" White Oak BT, original, old rotten face with axe marks, bears S60°W, 69<sup>0</sup> feet to face, (Markham called it a stump)

36" White Oak BT, faces overgrown, bears S82°W (Record 576°W), 89<sup>0</sup> feet to face.

16" Madrone BT, scribes not visible, I bark scribed "T30S, R6W, S13 BT," bears N67°W, 21<sup>0</sup> feet to center

Monument Detail

Sketch

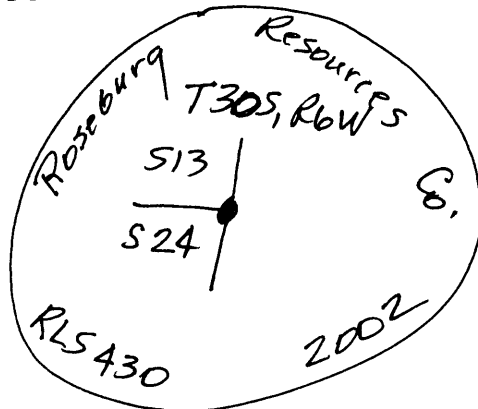

Monument Set (Procedures and Description)

See above.

New Accessories

8" Madrone BT, I bark scribed "T30S, R6W, S13, BT" bears N65°W, 12<sup>0</sup> feet, to center.

6 Foot Steel Fence Post bears North, 1<sup>0</sup> foot.

Location & Comments

Alum. Cap & Iron Pipe is South, 6<sup>0</sup> feet from fence corner. Fence runs North & West from corner.

Compass Declination 20°E

Firm/Agency Shaner

Engineering, Inc.

Address P.O. Box 1430

Roseburg, Oregon 97470

Party Chief B. Shaner

Notes " "

Witness Ron Schneider

Surveyor's Seal

REGISTERED  
PROFESSIONAL  
LAND SURVEYOR

Bruce A Shaner

OREGON  
OCT. 4, 1957  
BRUCE A. SHANER  
430

C.S. File No 65/44-6 M

Renewal June 30, 2002