

FILED

Date: 7/23/2002 By: JP

This survey consists of:

Map: M 140-41

Narrative: _____

Corner Rpt: CS 65/44-7A

OREGON CORNER RESTORATION FORM

Section 26 Township 32S Range 4W

County Douglas & Jackson Date July 23, 2002

DOUGLAS COUNTY
SURVEYOR

Corner Designation

527 | 526
534 | 535

- Condition Report Only
- Not Found
- Renewed
- Unrecorded
- Surveyed In
- Referenced Out

Previous Renewals/Surveys, etc.


U.S.G.L.O. Surveyor Nicklin, 1896
U.S.B.L.M. " Thielsen, 1959

Monument(s) & Accessories Found: (Condition and Source)

Found 2 1/2" Iron Pipe with 3 1/4" Brass Cap, from which a:
26" D. Fir BT, face overgrown, bears N 29 1/2° E, 76 1/2 Feet.
36" D. Fir BT, " " , bears S 71° E, 74 1/2 Feet.
36" D. Fir BT stump, face overgrown, bears S 3° W, 49 1/2 feet.
(Record 52 1/2 feet) ↙
18" D. Fir BT, face d/grown, now blown down, but stump in
ground, bears N 81° W, 25 1/2 feet.

Monument Detail

Sketch

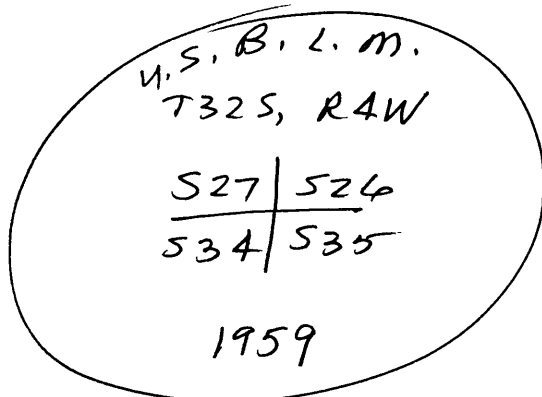

Monument Set (Procedures and Description)

None.

New Accessories

6 Foot Steel Fence Post bears N 3° W, 10 foot,
" " " " " " " East, 10 foot.

Location & Comments

Compass Declination 20° E
 Firm/Agency Shaner Engineering, Inc.
 Address P.O. Box 1430
Roseburg, Oregon 97470
 Party Chief B. Shaner
 Notes " "
 Witness Rev. Schneider
Gregg Dan Skine

Surveyor's Seal

REGISTERED
PROFESSIONAL
LAND SURVEYOR

Bruce A. Shaner
OREGON
OCT. 4, 1957
BRUCE A. SHANER
490

C.S. File No 65/44-7A

Renews June 30,
2004