

FILED

Date: 7/23/2002 By: JP

This survey consists of:

Map: M 140-41

Narrative: \_\_\_\_\_

Corner Rpt: CS 65/44-70

OREGON CORNER RESTORATION FORM

Section 26 Township 32S Range 4W

County Douglas & Jackson Date July 22, 2002

DOUGLAS COUNTY  
SURVEYOR

Corner Designation

$\frac{1}{4}$   $\frac{526}{535}$

- Condition Report Only
- Not Found
- Renewed
- Unrecorded
- Surveyed In
- Referenced Out

Previous Renewals/Surveys, etc.

U.S.G.L.D. Surveyor Nicklin, 1896

U.S.B.L.M. " Thielsen, 1959

Monument(s) & Accessories Found: (Condition and Source)


Found 2 1/2" Iron Pipe with a 3 1/4" Brass Cap, from which a:  
30" Cedar BT snag, now cut down, scribes visible on  
snag, bears N46°W, 49.5 feet.

28" D. Fir BT, face overgrown, bears N80°E,  
70.6 feet.

36" Cedar BT, face overgrown, bears S19°W,  
25.7 feet.

Monument Detail

Sketch

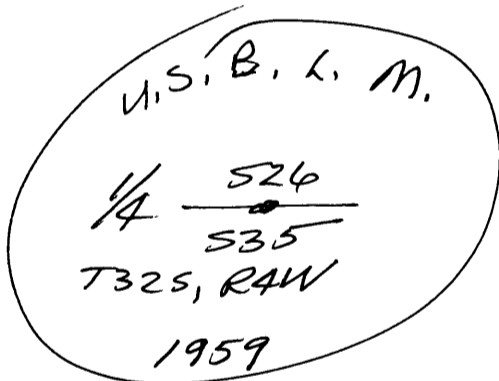

Monument Set (Procedures and Description)

None

New Accessories

6 Foot Steel Fence Post bears West, 10 feet.

Location & Comments

South of logging  
Road about 300  
feet.

Compass Declination 20°E

Firm/Agency Shaner

Engineering, Inc.

Address P.O. Box 1430

Roseburg, OR 97470

Party Chief B. Shaner

Notes " "

Witness Rev Schneider

Gregg Danskiwe

Surveyor's Seal

REGISTERED  
PROFESSIONAL  
LAND SURVEYOR

Bruce A. Shaner

OREGON  
OCT. 4, 1957  
BRUCE A. SHANER  
490

Renews June 30,  
2004

C.S. File No 65/44-70