

FILED

Date: 2-3-2003 By: JC

OREGON CORNER RESTORATION FORM

This survey consists of:  
Map: \_\_\_\_\_

Section 30 Township 30S Range 4W

Name: \_\_\_\_\_  
Corner Rpt: 65/45-1

County DOUGLAS Date 12-02-02

DOUGLAS COUNTY  
SURVEYOR

Corner Designation

100200	25	30
	36	31

- Condition Report Only
- Not Found
- Renewed
- Unrecorded
- Surveyed In
- Referenced Out

Previous Renewals/Surveys, etc. \_\_\_\_\_

Monument(s) & Accessories Found: (Condition and Source)

- 1963 DOUGLAS COUNTY SURVEYORS OFFICE I.P. & B.C.
- 10" FIR SNAG N56W 21<sup>3</sup> NOW 8" TALL STUMP
- 22" FIR N79E 44<sup>2</sup> HEALED
- 42" FIR S16E 10<sup>6</sup> HEALED (RECORD 46")
- 30" FIR S18W 23<sup>1</sup> STUMP (RECORD 34")
- 26" FIR N75W 113<sup>8</sup> STUMP 4' TALL WITH METAL CAP (UNKNOWN ORIGIN)

Monument Detail

Sketch

Monument Set (Procedures and Description)


New Accessories

- 7" FIR S72E 12<sup>5</sup> SCRIBED "S31 BT"
- 13" FIR S6W 37<sup>2</sup> SCRIBED "S36 BT"

Location & Comments

CORNER LIES ABOUT Compass Declination 19 1/2°  
70' SOUTH OF NEW Firm/Agency ROSEBURG  
LOGGING RD. Forest Products  
 Address PO Box 1088  
ROSEBURG OREGON 97470  
 Party Chief Bill Olson  
 Notes \_\_\_\_\_  
 Witness MIKE FROMDAHL

Surveyor's Seal

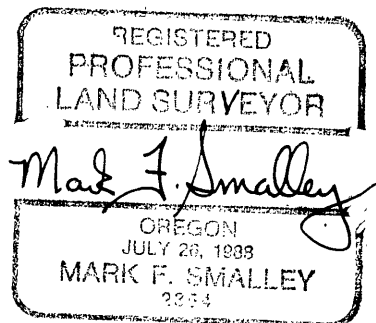

RENEWS 6/30/04

C.S. File No 65/45-1