

FILED

Date: 2/11/2003 By: JC

This survey consists of:
Map: _____
Nearest: _____
Corner Ref: 65/45-2

OREGON CORNER RESTORATION FORM

Section 16 Township 32S Range 1W

County DOUGLAS Date 10-4-02

DOUGLAS COUNTY
SURVEYOR

Corner Designation

W ¹/₄

- Condition Report Only
- Not Found
- Renewed
- Unrecorded
- Surveyed In
- Referenced Out

Previous Renewals/Surveys, etc. COUNTY RENEWAL 79

Monument(s) & Accessories Found: (Condition and Source)

DOUGLAS COUNTY SURVEYORS OFFICE IRON PIPE & BRASS CAP

16" HEMLOCK SNAG S45W 26' SCRIBED VISIBLE

20" D. FIR S77E 52' HEALED

ROTTEW ROOTWAD S34W 2'

Monument Detail

Sketch

Monument Set (Procedures and Description)

New Accessories

9" FIR N14W 13' SCRIBED "1/4 BT"

9" FIR S53E 9' SCRIBED "1/4 BT"

9" FIR S4W 11' SCRIBED "1/4 BT"

Location & Comments

CORNER LIES 40' WEST Compass Declination 19 1/2°

OF OLD LOGGING ROAD Firm/Agency ROSEBURG

FOREST PRODUCTS

Address PO Box 1088


ROSEBURG OREGON 97470

Party Chief BILL OLSON

Notes _____

Witness MIKE FROMDAHL

Surveyor's Seal

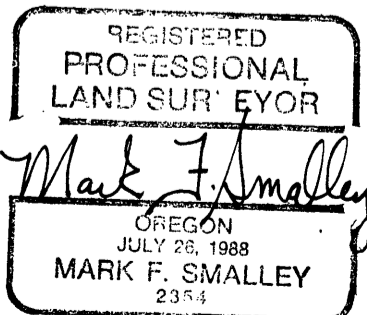

RENEWS 6/20/04

C.S. File No 65/45-2