

FILED

Date: 2/11/2003 By: JC

This survey consists of:

Map: \_\_\_\_\_

Nearest: \_\_\_\_\_

Corner Map: 65/45-3

OREGON CORNER RESTORATION FORM

Section 29/30 Township 23S Range 4W

County DOUGLAS Date 2/4/03

DOUGLAS COUNTY  
SURVEYOR

Corner Designation

S  $\frac{1}{16}$  Sec. 29  $\frac{1}{30}$

- Condition Report Only
- Not Found
- Renewed
- Unrecorded
- Surveyed In
- Referenced Out

Previous Renewals/Surveys, etc. \_\_\_\_\_


Monument(s) & Accessories Found: (Condition and Source)

3 1/4" BC up 0<sup>40</sup> in good condition (BLM)

22" D. FIR BT S 27°E 33 1/2 lks, SCAR VISIBLE. FIR HAS  
2 stems w/ SCAR ON NW stem. Diameter meas.  
ON NW stem 6" above ground

9" FIR NOW 19" FIR STUMP TIPPED OVER. Root hole  
at B&D S 56°W 38 1/2 lks. SCAR VISIBLE

Monument Detail

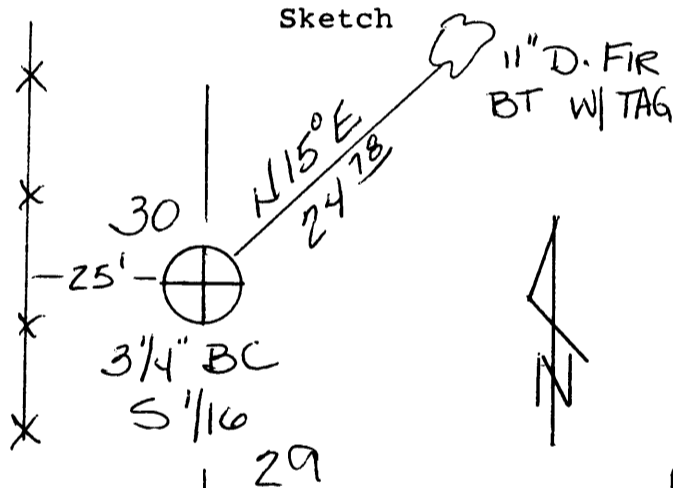

Monument Set (Procedures and Description)

New Accessories

11" Dia. D. FIR, N 15° E 24' BT. Scribed  
"S 1/16 S 29 BT" w/ Tag

\* Dist. measurement to alum. nail set in bole of tree.  
Location & Comments

Surveyor's Seal

Compass Declination 19° E

Firm/Agency Sweeden

Land Surveying

Address 5211 Cole

Rd Oakland OR 97402

Party Chief C. Sweeden

Notes \_\_\_\_\_

Witness E. Wilds

REGISTERED  
PROFESSIONAL  
LAND SURVEYOR

OREGON  
CARL A. SWEEDEN  
2752  
JAN. 16, 1988

Exp 6/30/04

C.S. File No 65/45-3