

FILED

Date: 2/11/2003 By: X

This survey consists of:

Map: \_\_\_\_\_

Narrative: \_\_\_\_\_

Corner Rpt: 65/45-4

OREGON CORNER RESTORATION FORM

Section 29/30 Township 23S Range 4W

County Douglas Date 2/4/03

DOUGLAS COUNTY SURVEYOR

Corner Designation

E 1/4, Sec. 30

- Condition Report Only
- Not Found
- Renewed
- Unrecorded
- Surveyed In
- Referenced Out

Previous Renewals/Surveys, etc. \_\_\_\_\_

Monument(s) & Accessories Found: (Condition and Source)

3 1/4" BC at N/S/W fence cor. up 0 40' good condition

Sawed fir stump 34" Dia. N 72° E 96 lks, scribe vis., bark gone


Sawed fir stump 48" Dia. N 31 1/2° W 101 lks, bark partly gone no scribe vis.

8" madrone now 16", S 30 3/4° W 52 lks, healed, tag

Monument Detail

15" Madrone  
Scribed & Tagged

Sketch

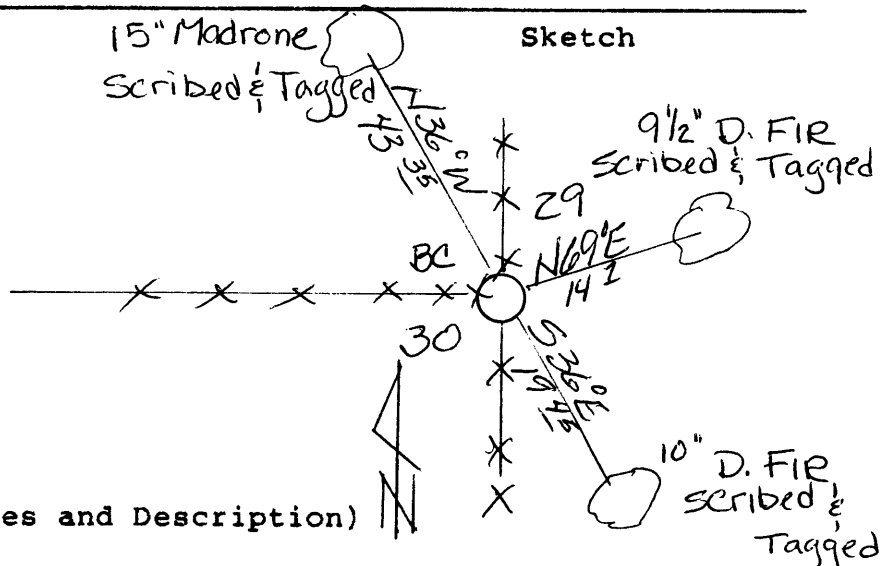

Monument Set (Procedures and Description)

None

New Accessories

15" Madrone BT, N 36° W 43 35' scribed "E 1/4 S 30 BT", Tag

9 1/2" D. fir BT, N 69° E 142', "W 1/4 S 29 BT", Tag

10" D. Fir BT, S 36° E 19 45', "W 1/4 S 29 BT", Tag

\* Measurements for dist. to alum. nail set in bole

Location & Comments

Surveyor's Seal

Compass Declination 19° E

Firm/Agency Sweeden

Land Surveying

Address 5211 Cole Rd

Oakland OR 97462

Party Chief C. Sweeden

Notes \_\_\_\_\_

Witness E. Wilds

REGISTERED PROFESSIONAL LAND SURVEYOR

Carl Sweeden

OREGON CARL A. SWEEDEN 2752 JAN. 10, 1906

Exp. 6/30/04

C.S. File No 65/45-4