

FILED

Date: 2/25/2003 By: JC

This survey consists of:

Map: _____

Name: _____

Corner No.: 65/45-5

OREGON CORNER RESTORATION FORM

Section 30 Township 21S Range 8W

County Douglas Date 2/19/03

DOUGLAS COUNTY
SURVEYOR

Corner Designation

Section Corner for 19, 20,
29, 30, T 21S R 8W W.M.

- Condition Report Only
- Not Found
- Renewed
- Unrecorded
- Surveyed In
- Referenced Out

Previous Renewals/Surveys, etc. _____

Monument(s) & Accessories Found: (Condition and Source)

19" D. fir, S 8 1/2° E, 29.0 ft., scribing visible


15" D. fir, S 24 1/2° W, 33.1 ft., scribing visible

18" D. fir, N 15° W, 32.1 ft., scribing visible

15" D. fir, N 51 1/2° E, 48.8 ft., scribing visible

Monument Detail

Sketch

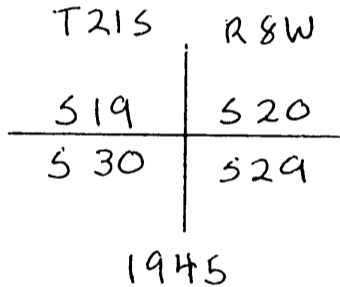

Monument Set (Procedures and Description)

NONE

New Accessories

NONE

Location & Comments

All B.T.'s painted and tagged.

Post set near corner.

Compass Declination _____

Firm/Agency Ward

Northwest Inc.

Address Po Box 105

Florence OR 97439

Party Chief Ron Rice

Notes _____

Witness Ben Pastor

Surveyor's Seal

REGISTERED
PROFESSIONAL
LAND SURVEYOR

Ronald L. Rice

OREGON
JULY 9, 2002
RONALD L. RICE
#54633 LS

EXPIRES: 12/31/04

C.S. File No 65/45-5