


PUBLIC LAND CORNERS

FILED MAR 31 2003

WEYERHAEUSER COMPANY
 SPRINGFIELD BRANCH

TOWNSHIP 23 S RANGE 3W
 SECTION 7 CORNER W 1/4
 COUNTY Lane-Douglas line OREGON

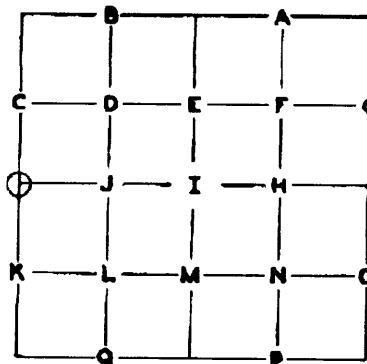

GLO SURVEY RECORD				PRESENT CONDITION - (DESCRIBE FULLY - USE PAGE 2 IF NEEDED FOR EXPLANATION.)
DATE: <u>1885</u>				
CORNER <u>Post</u>				No trace
ACCESSORIES:				
8" Fir	BEARING- N 63 W	LINKS- 17	FEET- 11.2	Not Found
8" Fir	S 27 E	25	16.5	" "
W. N. Haines SURVEY RECORD				PRESENT CONDITION:
DATE: <u>N.v. 1963</u>				
Transit Survey				
Set "T" iron and scribed:				Found "T" iron in place
5" Douglas Fir	S 31 E	6.3'		6" Douglas fir scribing visible upper and lower faces.
6" Douglas Fir	N 15 W	6.4'		8" Douglas fir scribing visible upper and lower faces.

CORNER SET: "T" iron as set by Haines Survey MAG. DECL.: 20 degrees

BEARING AND DISTANCE TO ABOVE IDENTIFIED SURVEY ACCESSORIES:

BEARING-	FEET-	SURVEY-	
S 31 E	6.1	Haines 63	to scribed face
N 15 W	6.2	" "	" " "

ACCESSORIES ADDED THIS DATE:

MAGNETIC DECLINATION 20 degrees

	BEARING	FEET	ORIG. B.T.	"W" NAIL	PLATE	BRASS DISC
6" Douglas Fir	S 30 E	6.0	Haines 1963	X	X	---
8" Douglas Fir	N 15 W	6.0	"	X	X	---

IDENTIFIED ON PHOTO:

INFORMATION ON LOCATION OF CORNER AS NOW SET:

GROUND COVER: Sisal, 20 year old reproduction

(USING FORM LINES SKETCH TOPOG AT CORNER ON PAGE 2 PLAT)

SLOPE FACES (GIVE BEARING IN DEGREES) S 50 W ON MINUS (-) 38 %

FROM CORNER -

NORTH: + 25%

SOUTH: - 25%

EAST: Level

WEST: - 15%

WORK DONE FOR W. CO.

FIELD NOTES IN BOOK: _____

BY: Glen McChesney DATE: 8/7/68

~~BRONNER SURVEYOR~~

ASSISTED BY: _____

COPIES SENT TO: _____

UNDER THE SUPERVISION OF:

SEAL

PAGE 3

C.S. File No 65/45-9B