


PUBLIC LAND CORNER

INDEX NO. _____

WEYERHAEUSER COMPANY
WILLAMETTE REGION

TOWNSHIP 22 SOUTH RANGE 4 WEST
SECTION 10 CORNER EAST 1/4
COUNTY DOUGLAS OREGON

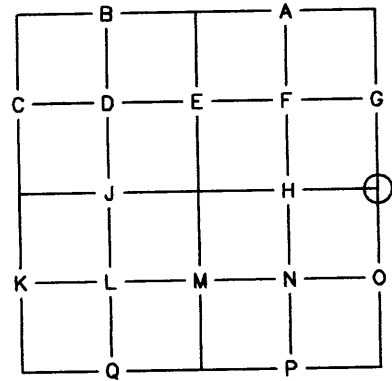

ORIGINAL CORNER DATED: 1884 BY: GLO - W.P. WRIGHT
CORNER: POST AND STONE MARKED "1/4 S" ON WEST FACE
ACCESSORIES: 40" FIR, S 10 W, 3 LKS.
14" FIR, N 80 E, 5 LKS.

RE-ESTABLISHMENT NOTES DATED: 1901 BY: GLO - O. THIEL
EVIDENCE RECOVERED: CHANGED BEARINGS ON ORIGINAL BT'S
40" FIR, S 10 E, 3 LKS.
14" FIR, S 80 W, 5 LKS.
CORNER SET: _____
ACCESSORIES ESTABLISHED: _____

RE-ESTABLISHMENT NOTES DATED: 1958 BY: GLEN McCHESNEY
EVIDENCE RECOVERED: STONE
46" FIR, S 7 W, 5.8 FEET, BARK SCRIBING VISIBLE
ROOT HOLE FOR 14" FIR, N 80 E, 3.3 FEET
CORNER SET: _____
ACCESSORIES ESTABLISHED: 34" FIR STUMP, N 77 W, 20.7 FEET TO "W" NAIL
38" I. CEDAR, N 25 E, 22.8 FEET TO "W" NAIL


RE-ESTABLISHMENT NOTES DATED: 1965 BY: DOUGLAS COUNTY
EVIDENCE RECOVERED: STONE - DISTURBED
48" FIR STUMP, S 10 E, 2.0 FEET, BARK SCRIBING VISIBLE
CORNER SET: 2-1/2" DOUGLAS CO. BRASS CAP DATED 1965
ACCESSORIES ESTABLISHED: 18" I. CEDAR, S 31 E, 29.0 FEET
14" I. CEDAR, S 61 W, 26.5 FEET

REMONUMENTATION


DATE: 1/20/03 BY: DAVID WELLMAN TITLE: PLS 2163 FIRM: D. WELLMAN SURVEYING
EVIDENCE RECOVERED: 2-1/2" DCSO BRASS CAP DATED 1965 - 0.5 FEET ABOVE GROUND
48" FIR STUMP, S 10 E, 2.0 FEET TO FACE
ROTTEN 34" FIR STUMP, N 60 W, 18.5 FEET TO "W" NAIL
38" I. CEDAR, 1958 WEYCO TAG READS S 25 W, 22.8 FEET - DOWN AND OUT
32" I. CEDAR, S 24 E, 29.1 FEET TO SPIKE SET SIDE CENTER - CLOSED FACE
31" I. CEDAR, S 64-1/2 W, 26.2 FEET TO SPIKE SET SIDE CENTER - CLOSED FACE
CORNER SET: _____
ACCESSORIES ESTABLISHED: 12" FIR, S 83 E, 18.0 FEET TO SPIKE SET SIDE CENTER -
SCRIBED "1/4 S11 BT"
14" FIR, N 65 W, 12.0 FEET TO SPIKE SET SIDE CENTER - SCRIBED "1/4 S10 BT"

OTHER INFORMATION: _____

SECTION 10 TOWNSHIP 22 S RANGE 4 W

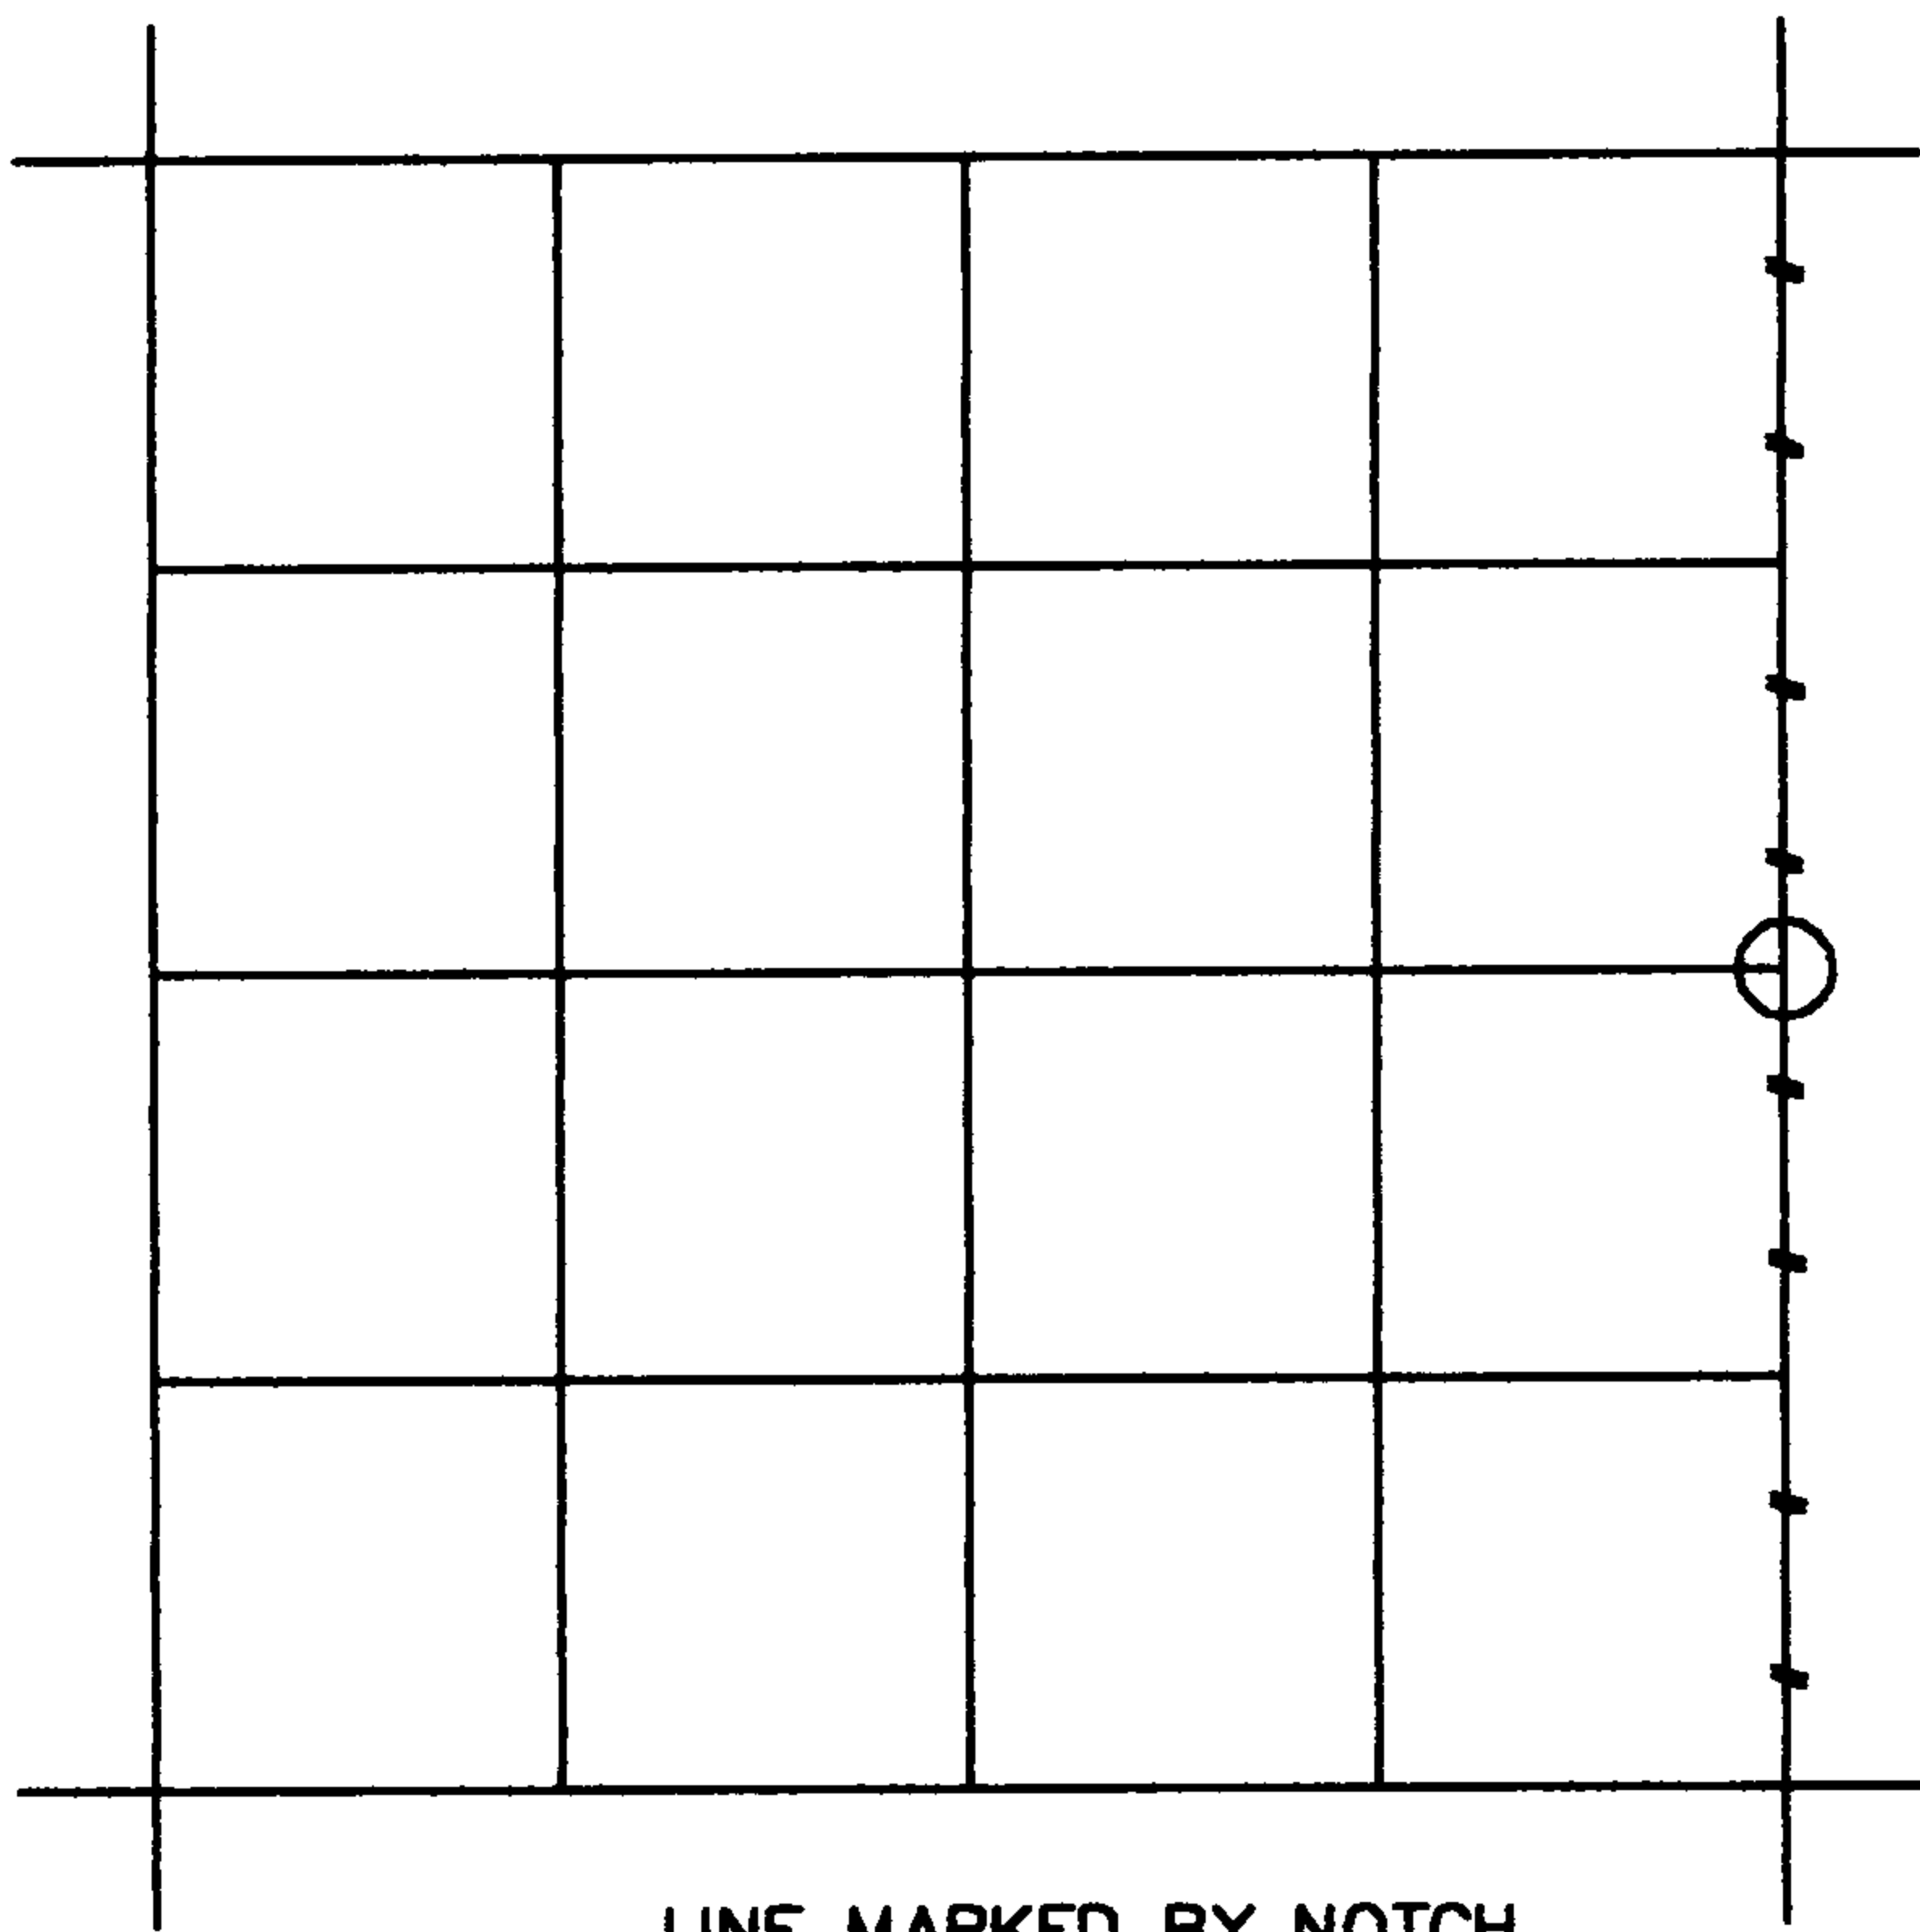


- LINE MARKED BY NOTCH CUT IN BLAZE
- KNOWN CORNER
- REFERENCED CORNER BY WEYERHAEUSER METHOD

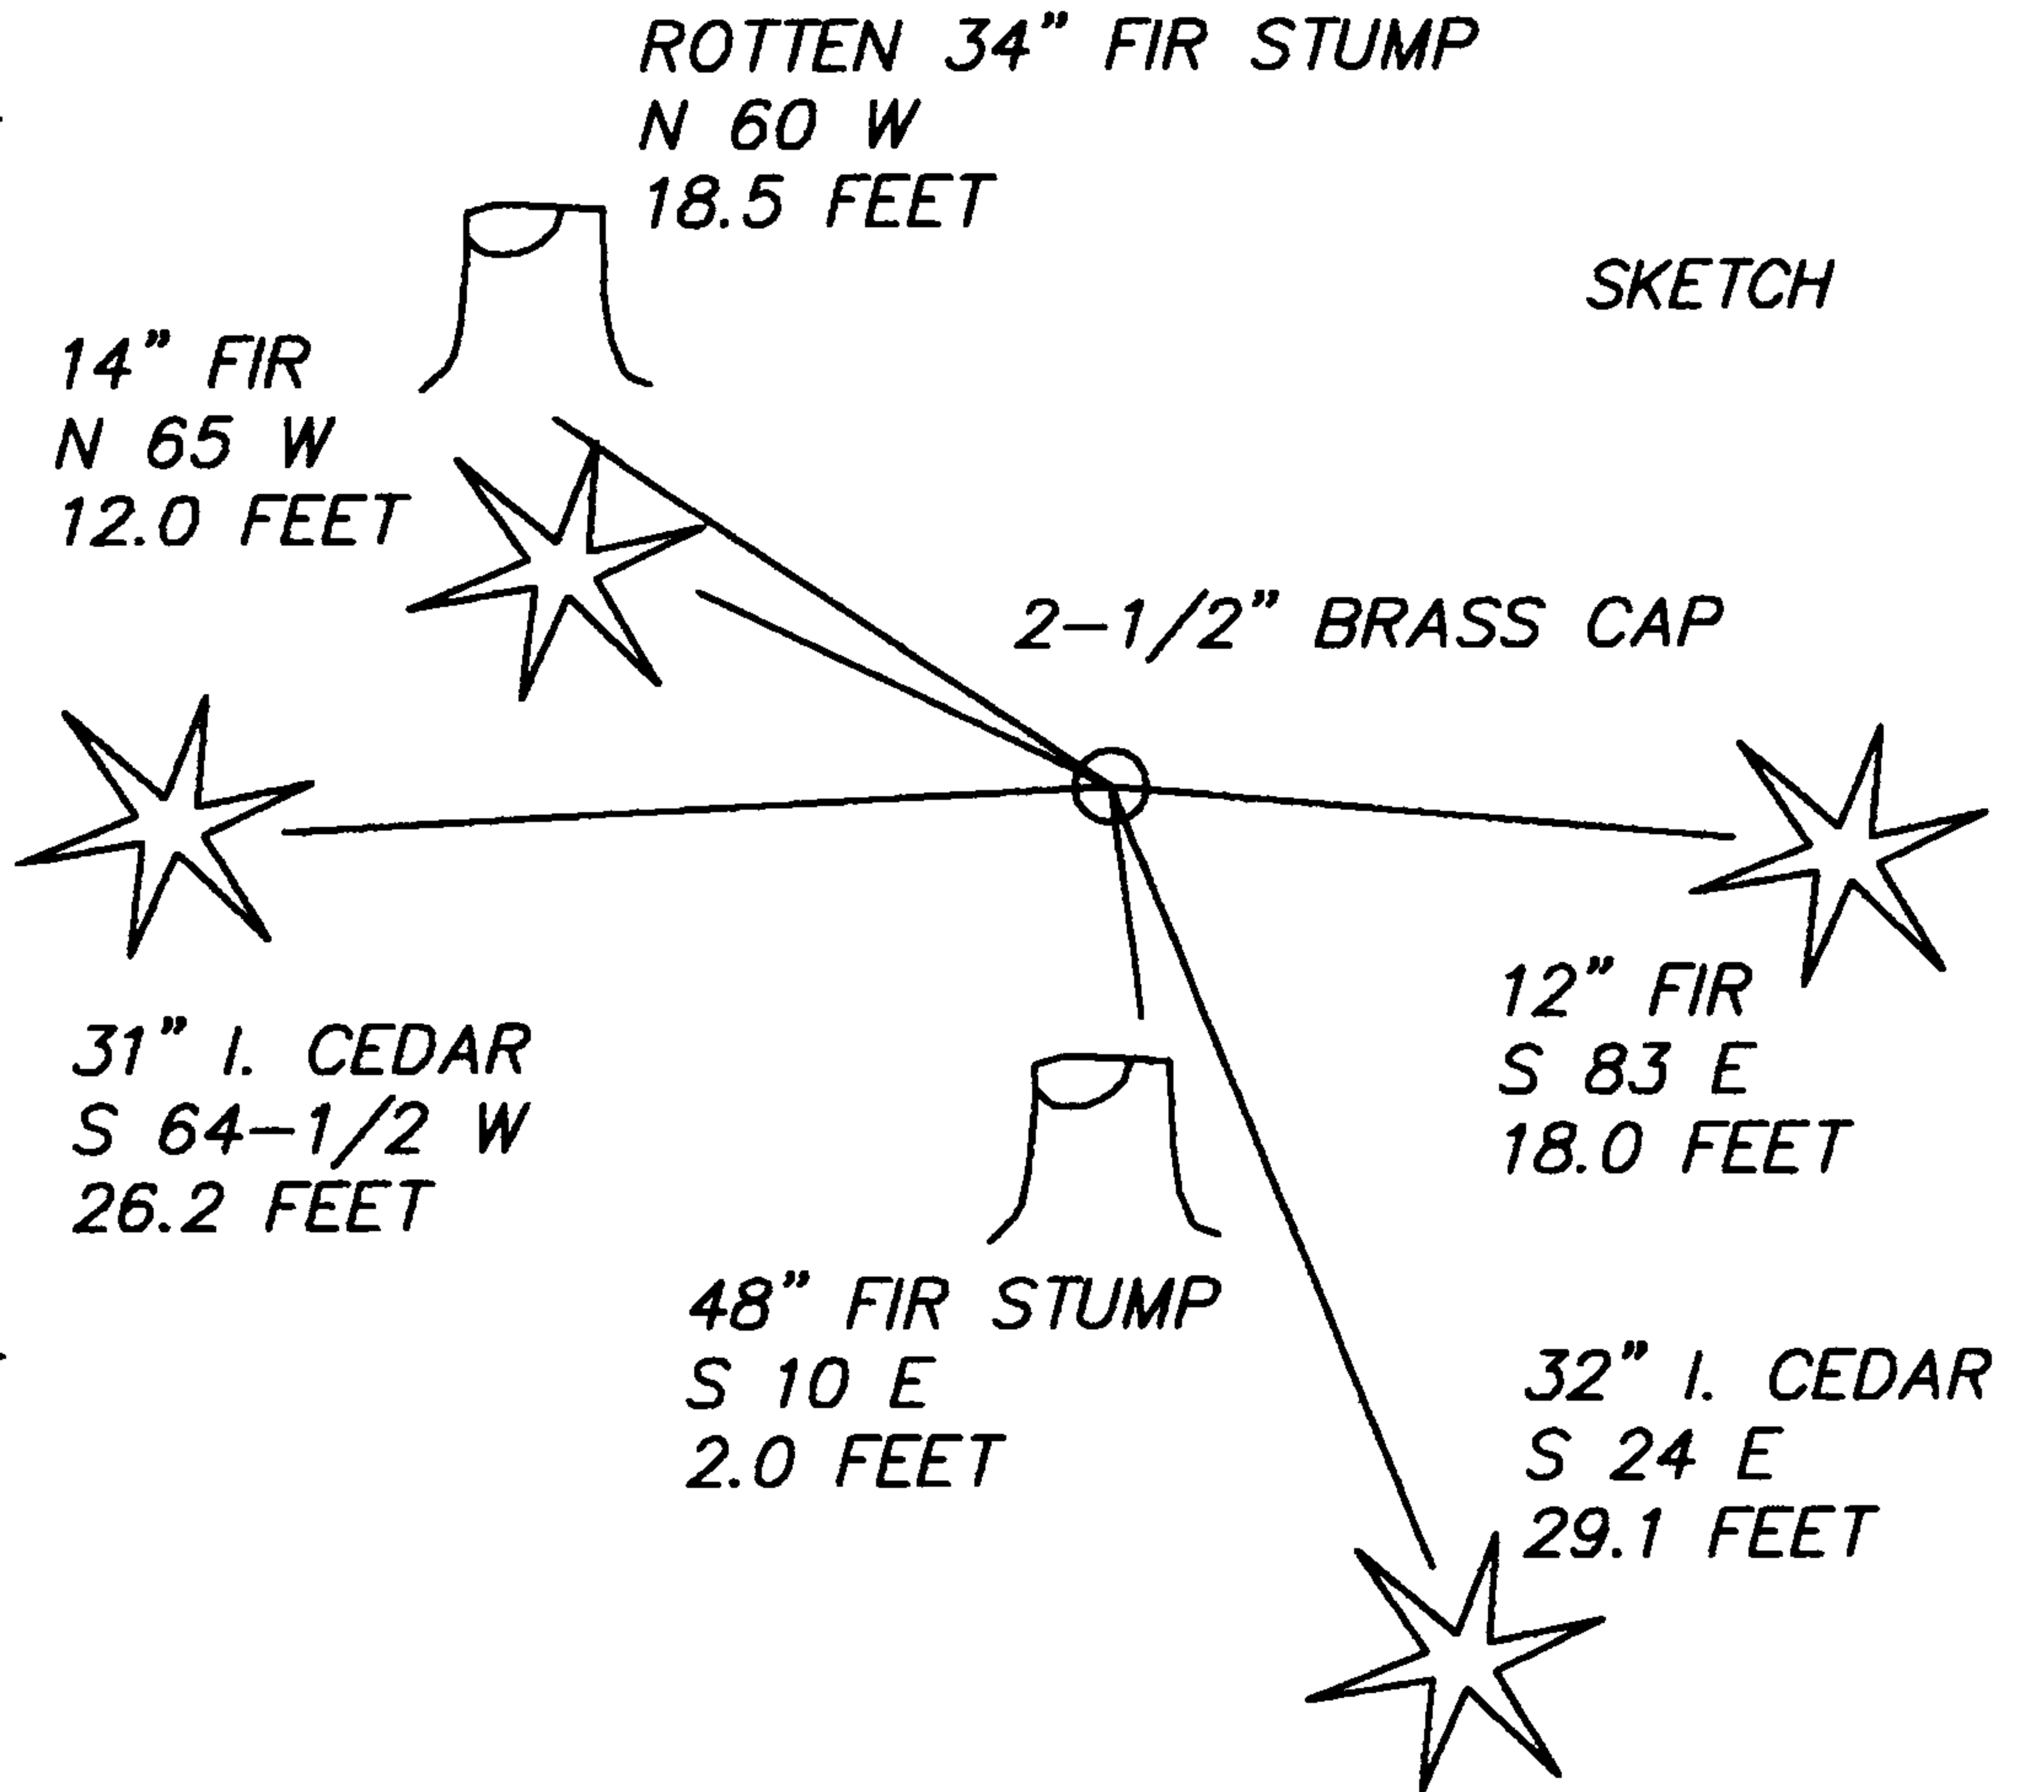

WEYERHAEUSER COMPANY
CORNER REFERENCE METHOD

A "W" NAIL DRIVEN INTO A NOTCH LOW ON A TREE OR STUMP. TWO BLAZES SCRIBED AS APPROPRIATE TO CORNER LOCATION. AN INSCRIBED BEARING TREE TAG PLACED HEAD HIGH WITH DISTANCE AND BEARING FROM THE "W" NAIL TO THE CORNER. PAINTED BAND ABOVE THE TAG.

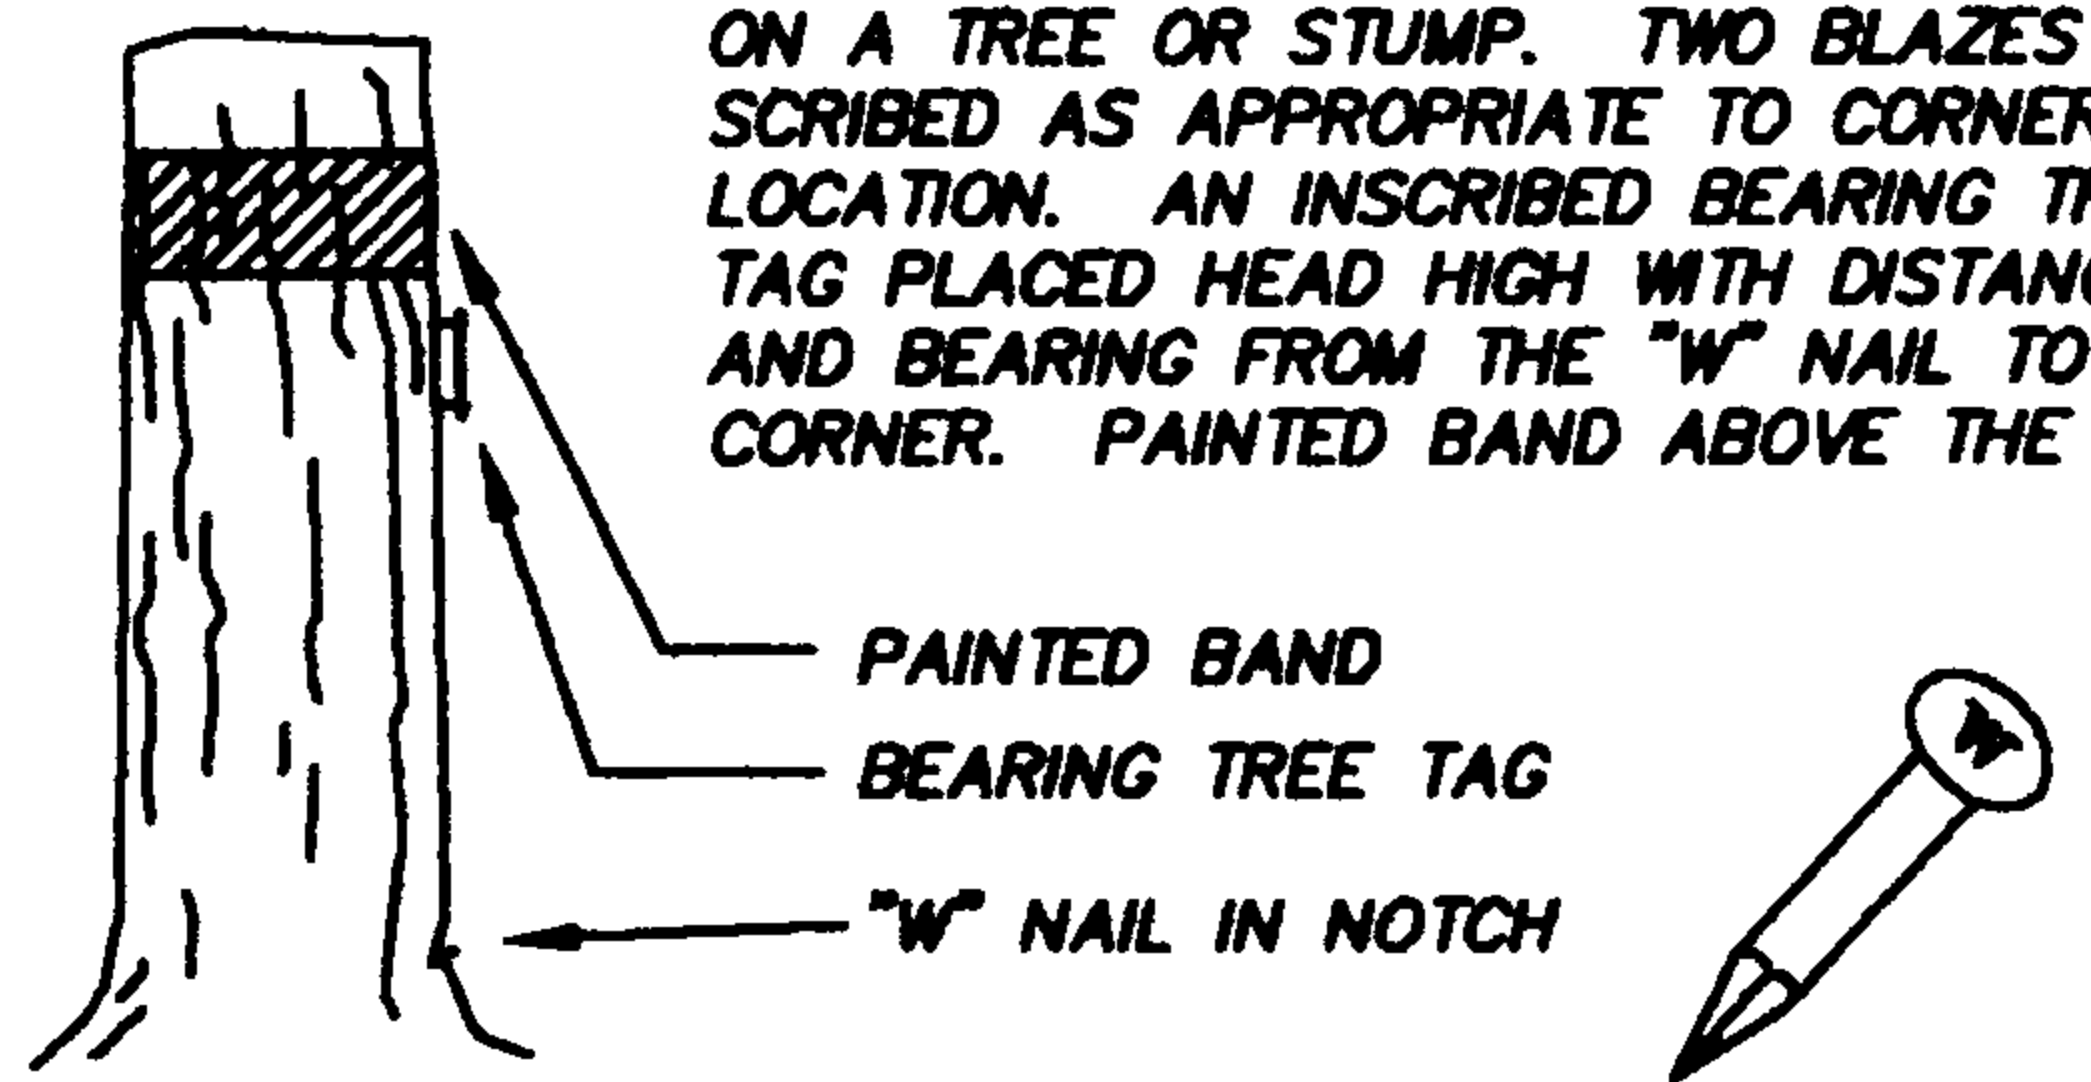

IDENTIFIED ON PHOTO: _____

INFORMATION ON CORNER AS NOW SET

GROUND COVER: FIR TO 20", SALAL, FERN

SLOPE FACE (BEARING) WEST (-) 35 %

FROM CORNER

| | |
|-------|---|
| NORTH | <u>+5% FOR 100' TO CREEK FLOWING WEST</u> |
| SOUTH | <u>-20% FOR 25' THEN LEVEL</u> |
| EAST | <u>+22%</u> |
| WEST | <u>-35%</u> |

BY: DAVID WELLMAN DATE: 1/20/03

FIRM: D. WELLMAN SURVEYING

ASSISTED BY: ERIN HEATHERSTONE

COPIES TO: DOUGLAS COUNTY

ORS 672-025

REGISTERED PROFESSIONAL LAND SURVEYOR

David H. Wellman

OREGON
JULY, 1985
DAVID H. WELLMAN
2163

RENEWAL 6/30/04