


PUBLIC LAND CORNER

INDEX NO. \_\_\_\_\_

WEYERHAEUSER COMPANY  
WILLAMETTE REGION

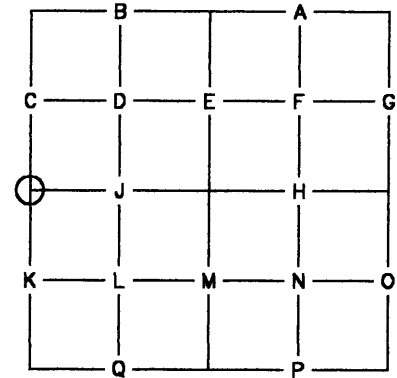

TOWNSHIP 23 SOUTH RANGE 3 WEST  
SECTION 7 CORNER WEST 1/4  
COUNTY LANE/DOUGLAS OREGON

ORIGINAL CORNER DATED: 1855 BY: GLO - GORDON

CORNER: POST

ACCESSORIES: \_\_\_\_\_

8" FIR, N 63 W, 17 LKS.

8" FIR, S 27 E, 25 LKS.

RE-ESTABLISHMENT NOTES DATED: 1963 BY: W. HAINES

EVIDENCE RECOVERED: \_\_\_\_\_

CORNER SET: 1"x1"x36" - "T" IRON

ACCESSORIES ESTABLISHED: \_\_\_\_\_

5" FIR, S 31 E, 6.3 FEET

6" FIR, N 15 W, 6.4 FEET

RE-ESTABLISHMENT NOTES DATED: 1968 BY: GLEN McCHESNEY - WEYERHAEUSER

EVIDENCE RECOVERED: 1"x1"x36" - "T" IRON

6" FIR, S 31 E, 6.1 FEET TO SCRIBED FACE

8" FIR, N 15 W, 6.2 FEET TO SCRIBED FACE

CORNER SET: \_\_\_\_\_

ACCESSORIES ESTABLISHED: \_\_\_\_\_

6" FIR, S 30 E, 6.0 FEET TO "W" NAIL - HAINES BT

8" FIR, N 15 W, 6.0 FEET TO "W" NAIL - HAINES BT

RE-ESTABLISHMENT NOTES DATED: \_\_\_\_\_ BY: \_\_\_\_\_

EVIDENCE RECOVERED: \_\_\_\_\_

CORNER SET: \_\_\_\_\_

ACCESSORIES ESTABLISHED: \_\_\_\_\_

REMONUMENTATION

DATE: 1/31/03 BY: DAVID WELLMAN TITLE: PLS 2163 FIRM: D. WELLMAN SURVEYING

EVIDENCE RECOVERED: 1" - "T" IRON, 1.0 FEET ABOVE GOUND LEVEL

15" FIR, S 27 E, 6.6 FEET TO CENTER, CLOSED FACE - HAINES BT

15" FIR, N 12 W, 5.8 FEET TO CENTER, CLOSED FACE - HAINES BT

CORNER SET: \_\_\_\_\_

ACCESSORIES ESTABLISHED: \_\_\_\_\_

12" FIR, S 86-1/2 W, 28.3 FEET TO SPIKE SET SIDE CENTER - SCRIBED "1/4 S12 BT"

18" FIR, S 71 E, 15.5 FEET TO SPIKE SET SIDE CENTER - SCRIBED "1/4 S7 BT"

OTHER INFORMATION: 6' METAL FENCE POST 1.0 FEET NORTH

