


PUBLIC LAND CORNER

INDEX NO. _____

WEYERHAEUSER COMPANY
WILLAMETTE REGION

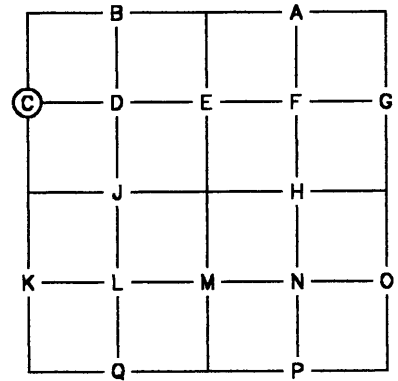

TOWNSHIP 23 SOUTH RANGE 3 WEST
 SECTION 7 CORNER N 1/16 W LINE
 COUNTY LANE/DOUGLAS OREGON

ORIGINAL CORNER DATED: 1963 BY: W. HAINES
 CORNER: 1"x1"x36" - "T" IRON
 ACCESSORIES: _____
6" RED CEDAR, S 29 W, 19.7 FEET
8" RED CEDAR, S 8 E, 21.6 FEET
 RE-ESTABLISHMENT NOTES DATED: _____ BY: _____
 EVIDENCE RECOVERED: _____

CORNER SET: _____
 ACCESSORIES ESTABLISHED: _____

RE-ESTABLISHMENT NOTES DATED: _____ BY: _____
 EVIDENCE RECOVERED: _____

CORNER SET: _____
 ACCESSORIES ESTABLISHED: _____

RE-ESTABLISHMENT NOTES DATED: _____ BY: _____
 EVIDENCE RECOVERED: _____

CORNER SET: _____
 ACCESSORIES ESTABLISHED: _____

REMONUMENTATION

DATE: 1/17/03 BY: DAVID WELLMAN TITLE: PLS 2163 FIRM: D. WELLMAN SURVEYING
 EVIDENCE RECOVERED: 1" X 1" "T" IRON - 0.4 FEET ABOVE GROUND
ROTTEN 14" RED CEDAR STUMP, S 31 W, 19.4 FEET TO CENTER - NO MARKS
28" RED CEDAR, S 7 E, 21.1 FEET TO SPIKE SET SIDE CENTER - CLOSED FACE
NEW FACE AND RESCRIBED "N 1/16 S 7 BT" - HAINES BT
ROTTEN 30" FIR STUMP - 5' TALL, S 62-1/2 W, 21.1 FEET TO "W" NAIL - WEYERHAUSER
TAG READS "N 61 E" 21.1 FEET

CORNER SET: _____
 ACCESSORIES ESTABLISHED: _____
24" FIR STUMP, N 31 E, 39.2 FEET TO SPIKE SET SIDE CENTER - SCRIBED "N 1/16 S7 BT"
11" HEMLOCK, S 55 W, 14.1 FEET TO SPIKE SET SIDE CENTER - SCRIBED "N 1/16 S12 BT"
 OTHER INFORMATION: 6' FENCE POST 1.0 FEET NORTH

