

RENEWAL

Monument Set (Procedure and Description)



SET 2 1/2" BRASS CAP ON 1 1/2" X 30" Iron Pipe
0.5 ABOVE GRADE.

USING A BEST FIT FROM FOUND
BEARING TREES.

THE BLACK OAK HAS A TAG THAT
SHOWED DISTANCE AS 14.3 AGAINST
RECORD (14.8).


USING 14.3 SEEMED TO MAKE THE
REMAINING BEARING TREES A BEST
FIT.

Monument Detail

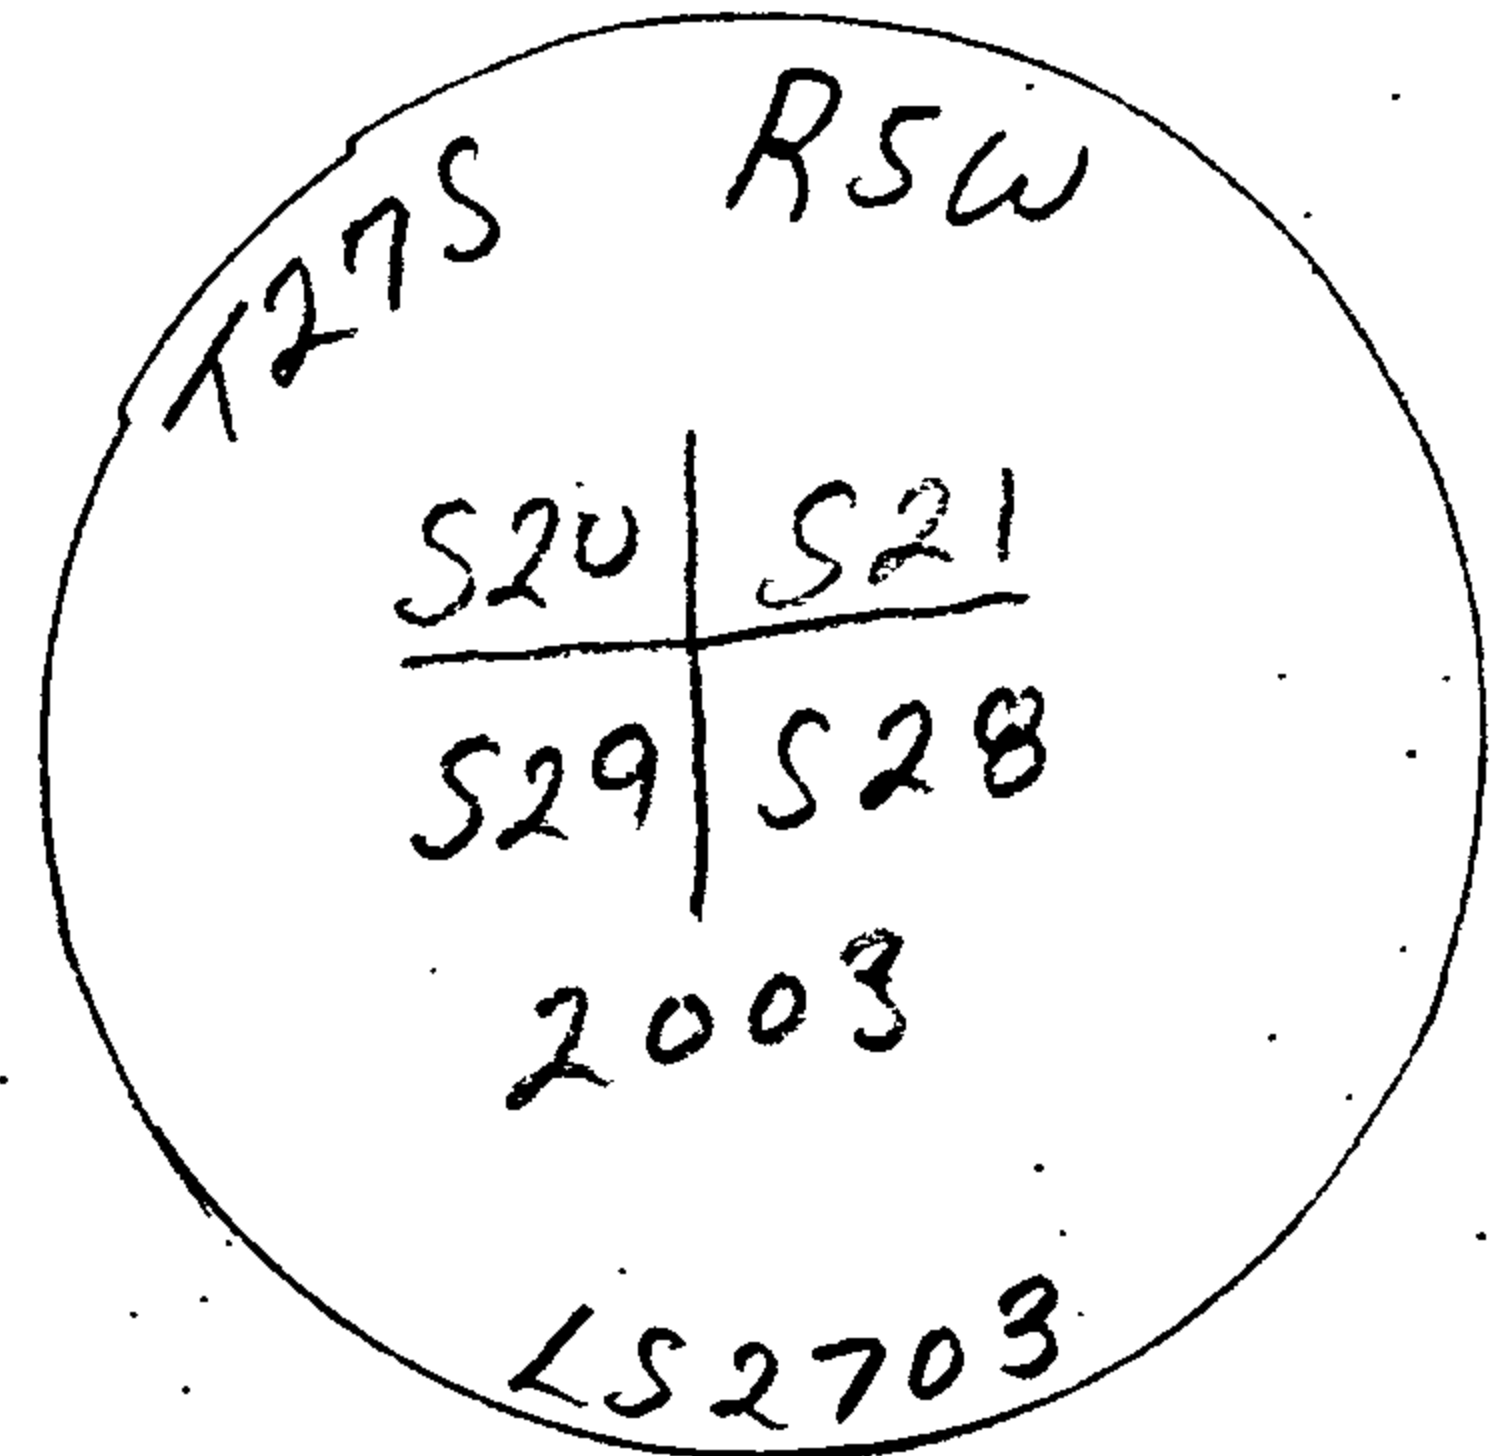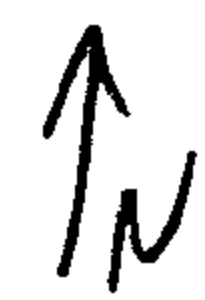

New Accessories



Sketch of Monument, Accessories, and General Area

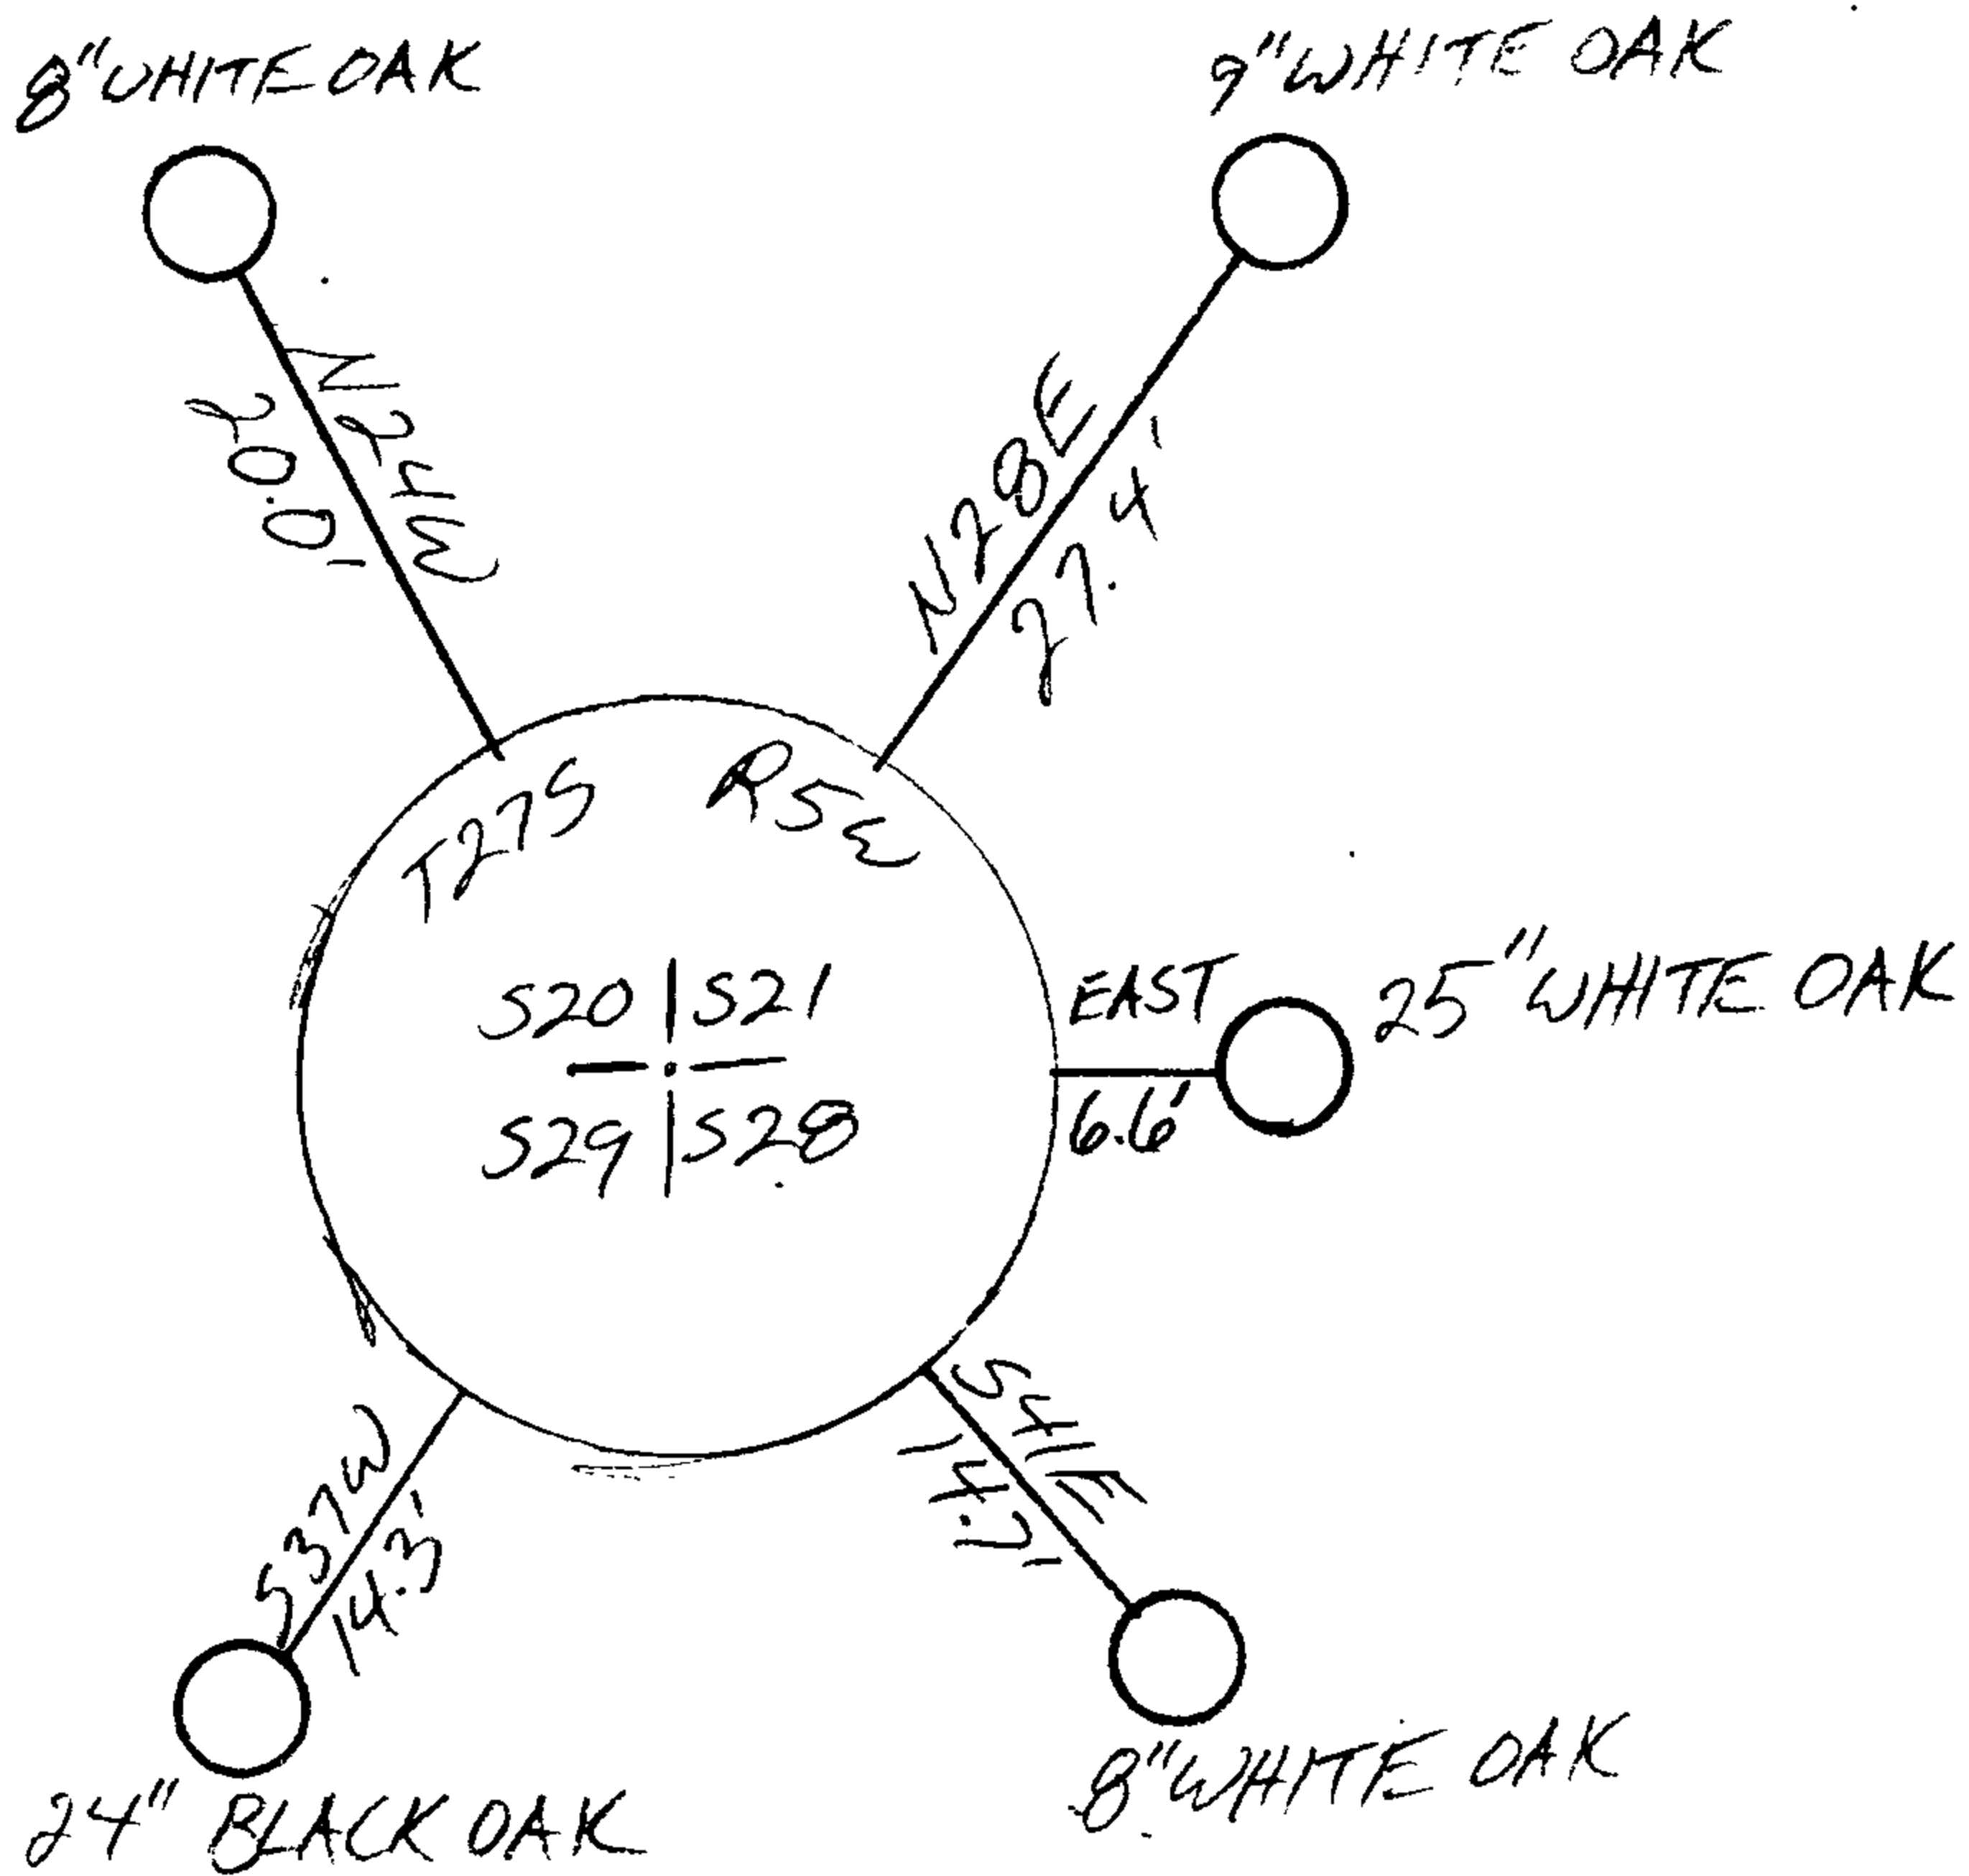

Location & Comments

Comp. Declin. 19° EAST
Agency I.E. ENGINEERING
Party Chief RYAN PALMER
Notekeeper _____
Witnesses BRUCE WEBSTER

Address 741 SE JACKSON
ROSEBURG, OR 97130

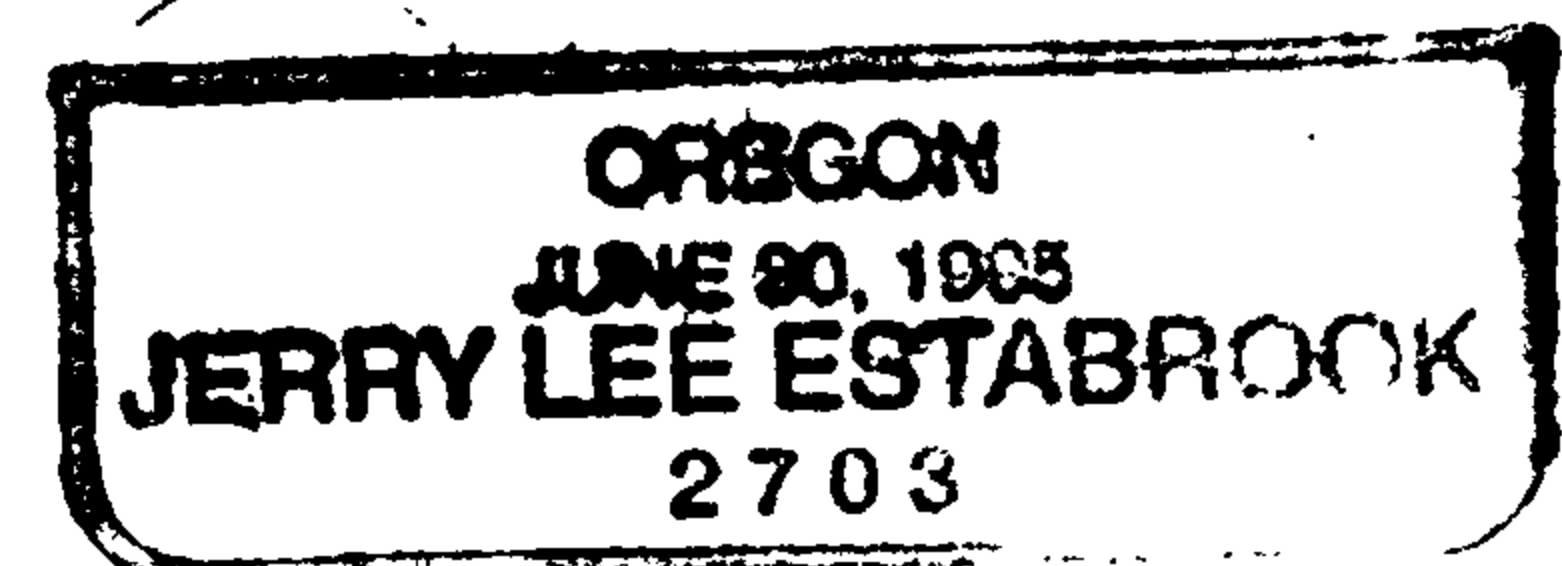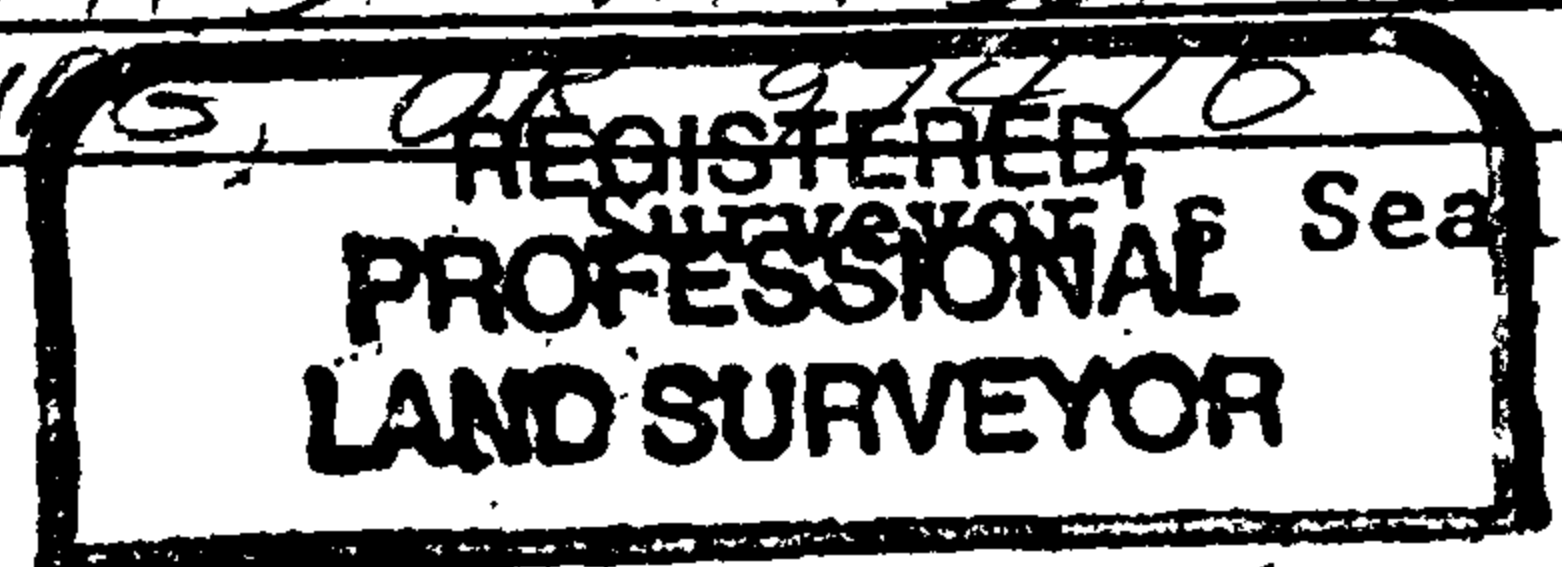

Exp. Date 12-31-03

65/45-15B