

GOVERNMENT CORNER RESTORATION FORM

Township 27S Range 6 WWM Sec. 11/2 County DOUGLAS

State OR Date 2/07/03 No. 540600

Corner Designation

Condition Report Only  
 Not Found  
 Renewed  
 Unrecorded  
 Surveyed In  
 Referenced Out


Previous Renewals

Monument(s) Found: (Condition and Source)

Found 2 1/2" BRASS CAP ON 1 1/2" GALVANIZED IRON PIPE 0'9" ABOVE GROUND

MONUMENT DETAIL

CAP FACES WEST NOT NORTH

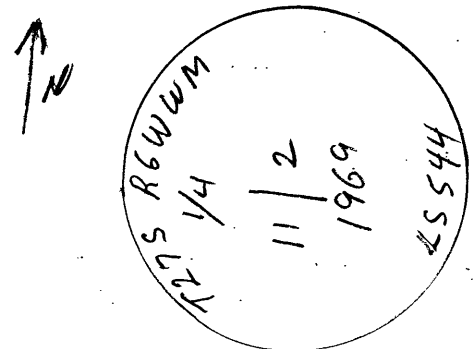

Accessories Found:

31" WHITE OAK WITH HEALD FACE - BEARS N62E, 82 1/2 FEET

16" ROTTEN STUMP - BEARS S49-30E, 40 1/2 FEET

FILED

Date: 4-8-2003 By: dc

This survey consists of:

Map:

Narrative:

Corner Rpt: 65/45-17A

DOUGLAS COUNTY SURVEYOR

C.S. File No 65/45-17A

