

FILED

Date: 5/8/2003 By: J

This survey consists of:

Map: _____
Name: _____
Corner Rpt: 65/45-28

OREGON CORNER RESTORATION FORM

Section 10 Township 25S Range 2W

County DOUGLAS Date 4-22-03

DOUGLAS COUNTY
SURVEYOR

Corner Designation


- Condition Report Only
- Not Found
- Renewed
- Unrecorded
- Surveyed In
- Referenced Out

Previous Renewals/Surveys, etc. M114-57

Monument(s) & Accessories Found: (Condition and Source)

MAPLE CLUSTER S201/2E 8" GOOD CONDITION
FIR STUMP N14W 14" GONE

Monument Detail

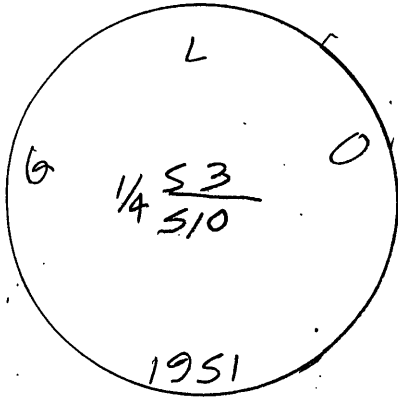

Sketch

Monument Set (Procedures and Description)


New Accessories

6" FIR N48W 35° FT SCRIBE - "53 BT"
16" FIR S48E 34³ FT " " "510 BT"
14" FIR N79E 28' FT " " 53 BT

Location & Comments

Compass Declination 20
 Firm/Agency RFP
 Address DILLARD
P.O. Box 1088, ROSEBURG, OR 97470
 Party Chief BILL OLSON
 Notes _____
 Witness MIKE FROMMELT

Surveyor's Seal

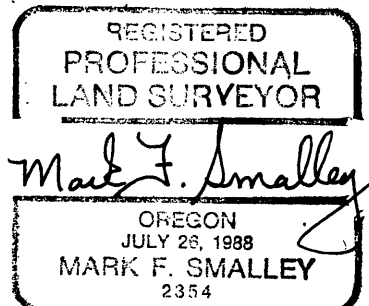

RENEWS 6/30/04

C.S. File No 65/45-28