

FILED

Date: 5/8/2003 By: XC

This survey consists of:

Map: \_\_\_\_\_

Name: \_\_\_\_\_

Corner Ref: 65/45-30

DOUGLAS COUNTY  
SURVEYOR

OREGON CORNER RESTORATION FORM

Section 24 Township 29S Range 8W

County DOUGLAS Date 4-29-03

Corner Designation

NE CORNER, SECTION 24

Previous Renewals/Surveys, etc. 700400

- Condition Report Only
- Not Found
- Renewed
- Unrecorded
- Surveyed In
- Referenced Out


Monument(s) & Accessories Found: (Condition and Source)

1924 GLD IPBC

16" FIR NORTH 1<sup>E</sup> HEALED

32" FIR SW 61<sup>E</sup> HEALED

Monument Detail

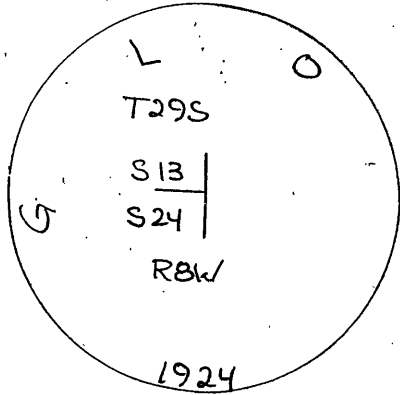

Sketch

Monument Set (Procedures and Description)

New Accessories

14" FIR S2W 15<sup>?</sup> SCRIBED "S24 BT"

21" HEMLOCK NSOW 43<sup>?</sup> SCRIBED "S13 BT"

Location & Comments

Compass Declination 20°

Firm/Agency ROSEBURG

FOREST PRODUCTS

Address PO Box 1088


ROSEBURG OREGON 97470

Party Chief Bill Olson

Notes \_\_\_\_\_

Witness MIKE FROMDAHL

Surveyor's Seal

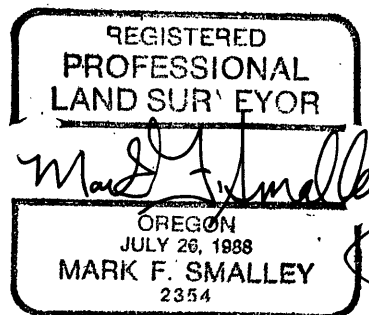

RENEWS 6/30/04

C.S. File No 65/45-30