


# PUBLIC LAND CORNER

FILED JUL 29 2003  
INDEX NO. 340240

**WEYERHAEUSER COMPANY**  
WILLAMETTE REGION

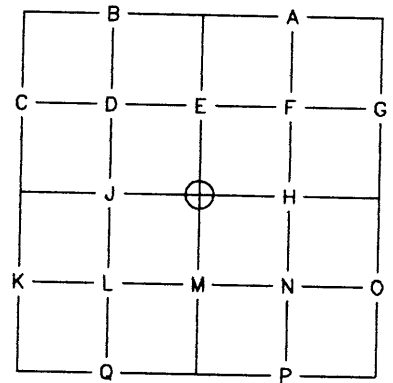

TOWNSHIP 23 SOUTH RANGE 3 WEST  
 SECTION 28 CORNER CENTER 1/4  
 COUNTY LANE/DOUGLAS OREGON

ORIGINAL CORNER DATED: 1959 BY: M. D. HALE - C.S. 51/25 & C.S. 53/107  
 CORNER: 1/2" X 36" IRON PIPE IN 42" FIR WINDFALL  
 ACCESSORIES: 36" FIR STUMP, N 62 W, 14.1 FEET TO "W" NAIL IN FACE  
65" FIR STUMP, N 12 W, 57.7 FEET TO "W" NAIL IN FACE

RE-ESTABLISHMENT NOTES DATED: \_\_\_\_\_ BY: \_\_\_\_\_  
 EVIDENCE RECOVERED: \_\_\_\_\_

CORNER SET: \_\_\_\_\_  
 ACCESSORIES ESTABLISHED: \_\_\_\_\_

RE-ESTABLISHMENT NOTES DATED: \_\_\_\_\_ BY: \_\_\_\_\_  
 EVIDENCE RECOVERED: \_\_\_\_\_

CORNER SET: \_\_\_\_\_  
 ACCESSORIES ESTABLISHED: \_\_\_\_\_


### REMONUMENTATION

DATE: 6/26/03 BY: DAVID WELLMAN TITLE: PLS 2163 FIRM: D. WELLMAN SURVEYING  
 EVIDENCE RECOVERED: 1/2" IRON PIPE IN DECAYING FIR WINDFALL  
36" FIR STUMP, WEYCO TAG READS "S 62 E, 14.1 FEET"  
65" FIR STUMP, N 8 W, 57.7 FEET TO "W" NAIL IN FACE - NEW WEYCO TAG SET

CORNER SET: \_\_\_\_\_

ACCESSORIES ESTABLISHED: 15" HEMLOCK STUMP, S 7-1/2 E, 5.8 FEET TO SPIKE SET SIDE CENTER - TAG AND NAIL ONLY  
25" FIR STUMP, N 9 W, 18.2 FEET TO SPIKE SET SIDE CENTER - TAG AND NAIL ONLY  
21" FIR STUMP, N 41 E, 31.1 FEET TO SPIKE SET SIDE CENTER - TAG AND NAIL ONLY  
 OTHER INFORMATION: \_\_\_\_\_

SECTION 28 TOWNSHIP 23 S RANGE 3 W

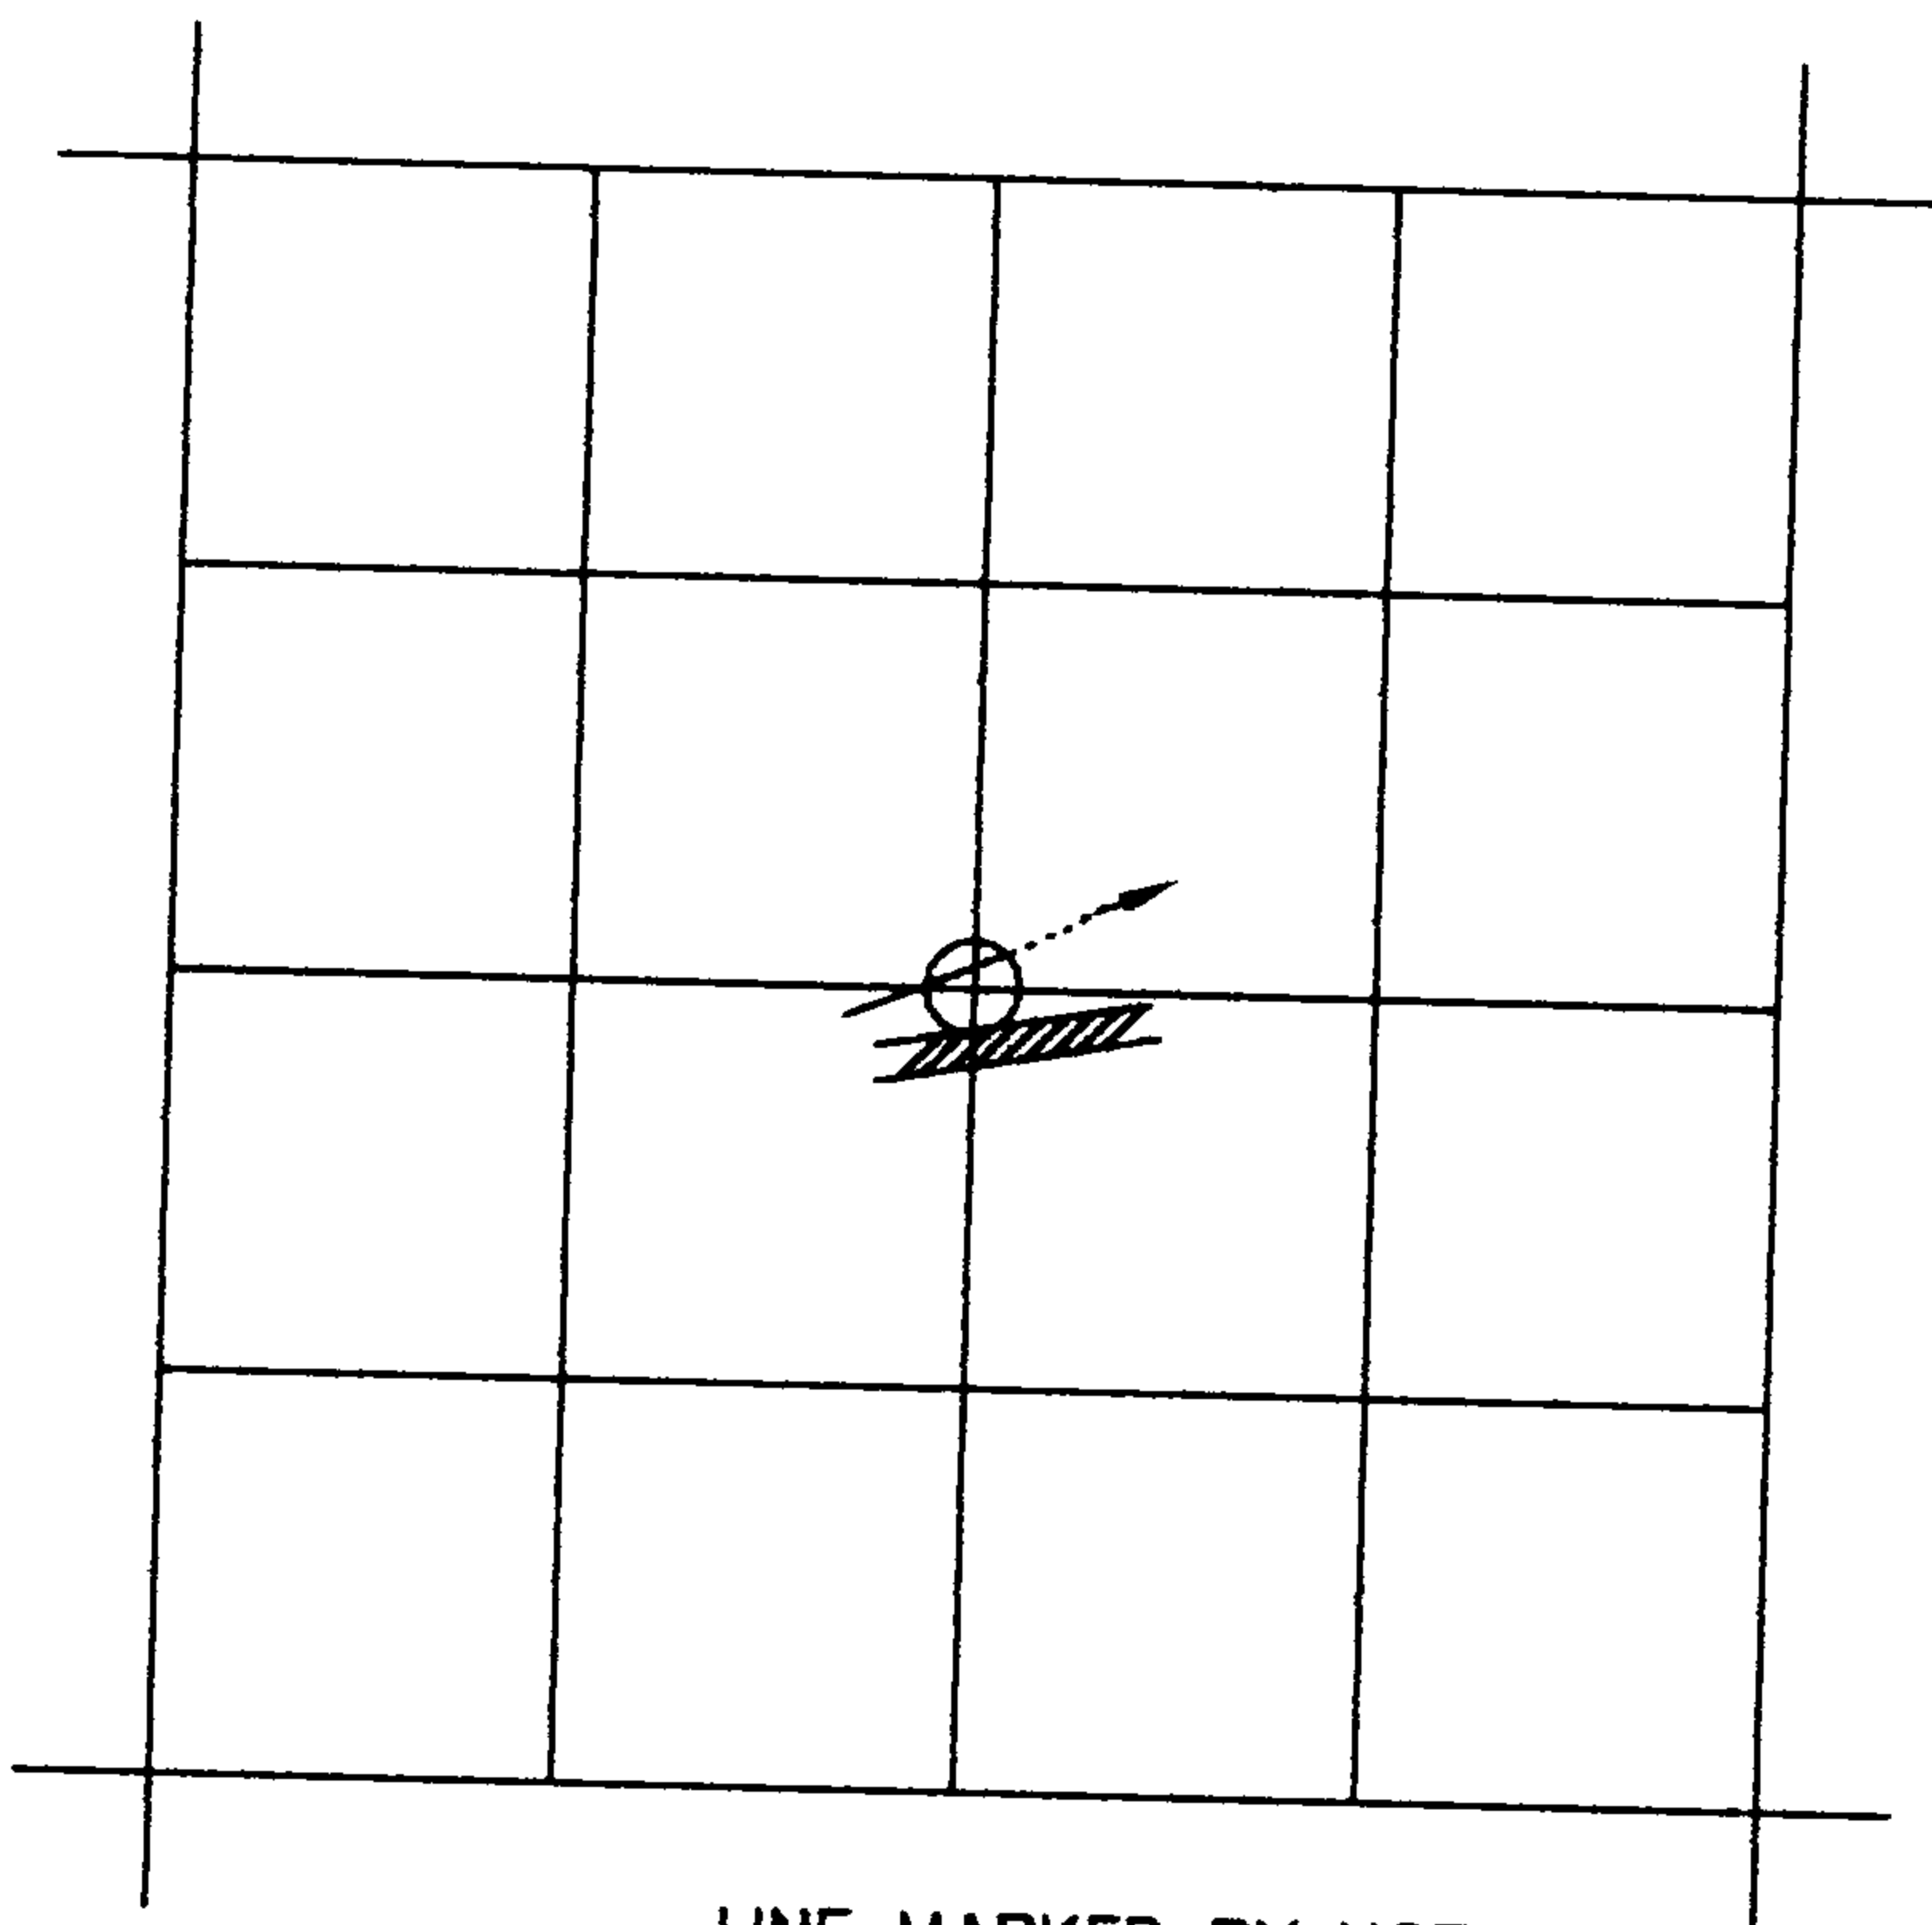

- LINE MARKED BY NOTCH CUT IN BLAZE
- KNOWN CORNER
- REFERENCED CORNER BY WEYERHAEUSER METHOD

65" FIR STUMP  
N 8 W  
57.7 FEET

SKETCH

21" FIR STUMP  
N 41 E  
31.1 FEET

25" FIR STUMP  
N 9 W  
18.2 FEET

32" FIR STUMP  
N 62 W  
14.1 FEET

1/2" IRON PIPE

15" HEMLOCK STUMP  
S 7-1/2 E  
5.8 FEET

\_\_\_\_\_

\_\_\_\_\_


\_\_\_\_\_

\_\_\_\_\_

\_\_\_\_\_

WEYERHAEUSER COMPANY  
CORNER REFERENCE METHOD

A "W" NAIL DRIVEN INTO A NOTCH LOW ON A TREE OR STUMP. TWO BLAZES SCRIBED AS APPROPRIATE TO CORNER LOCATION. AN INSCRIBED BEARING TREE TAG PLACED HEAD HIGH WITH DISTANCE AND BEARING FROM THE "W" NAIL TO THE CORNER. PAINTED BAND ABOVE THE TAG.

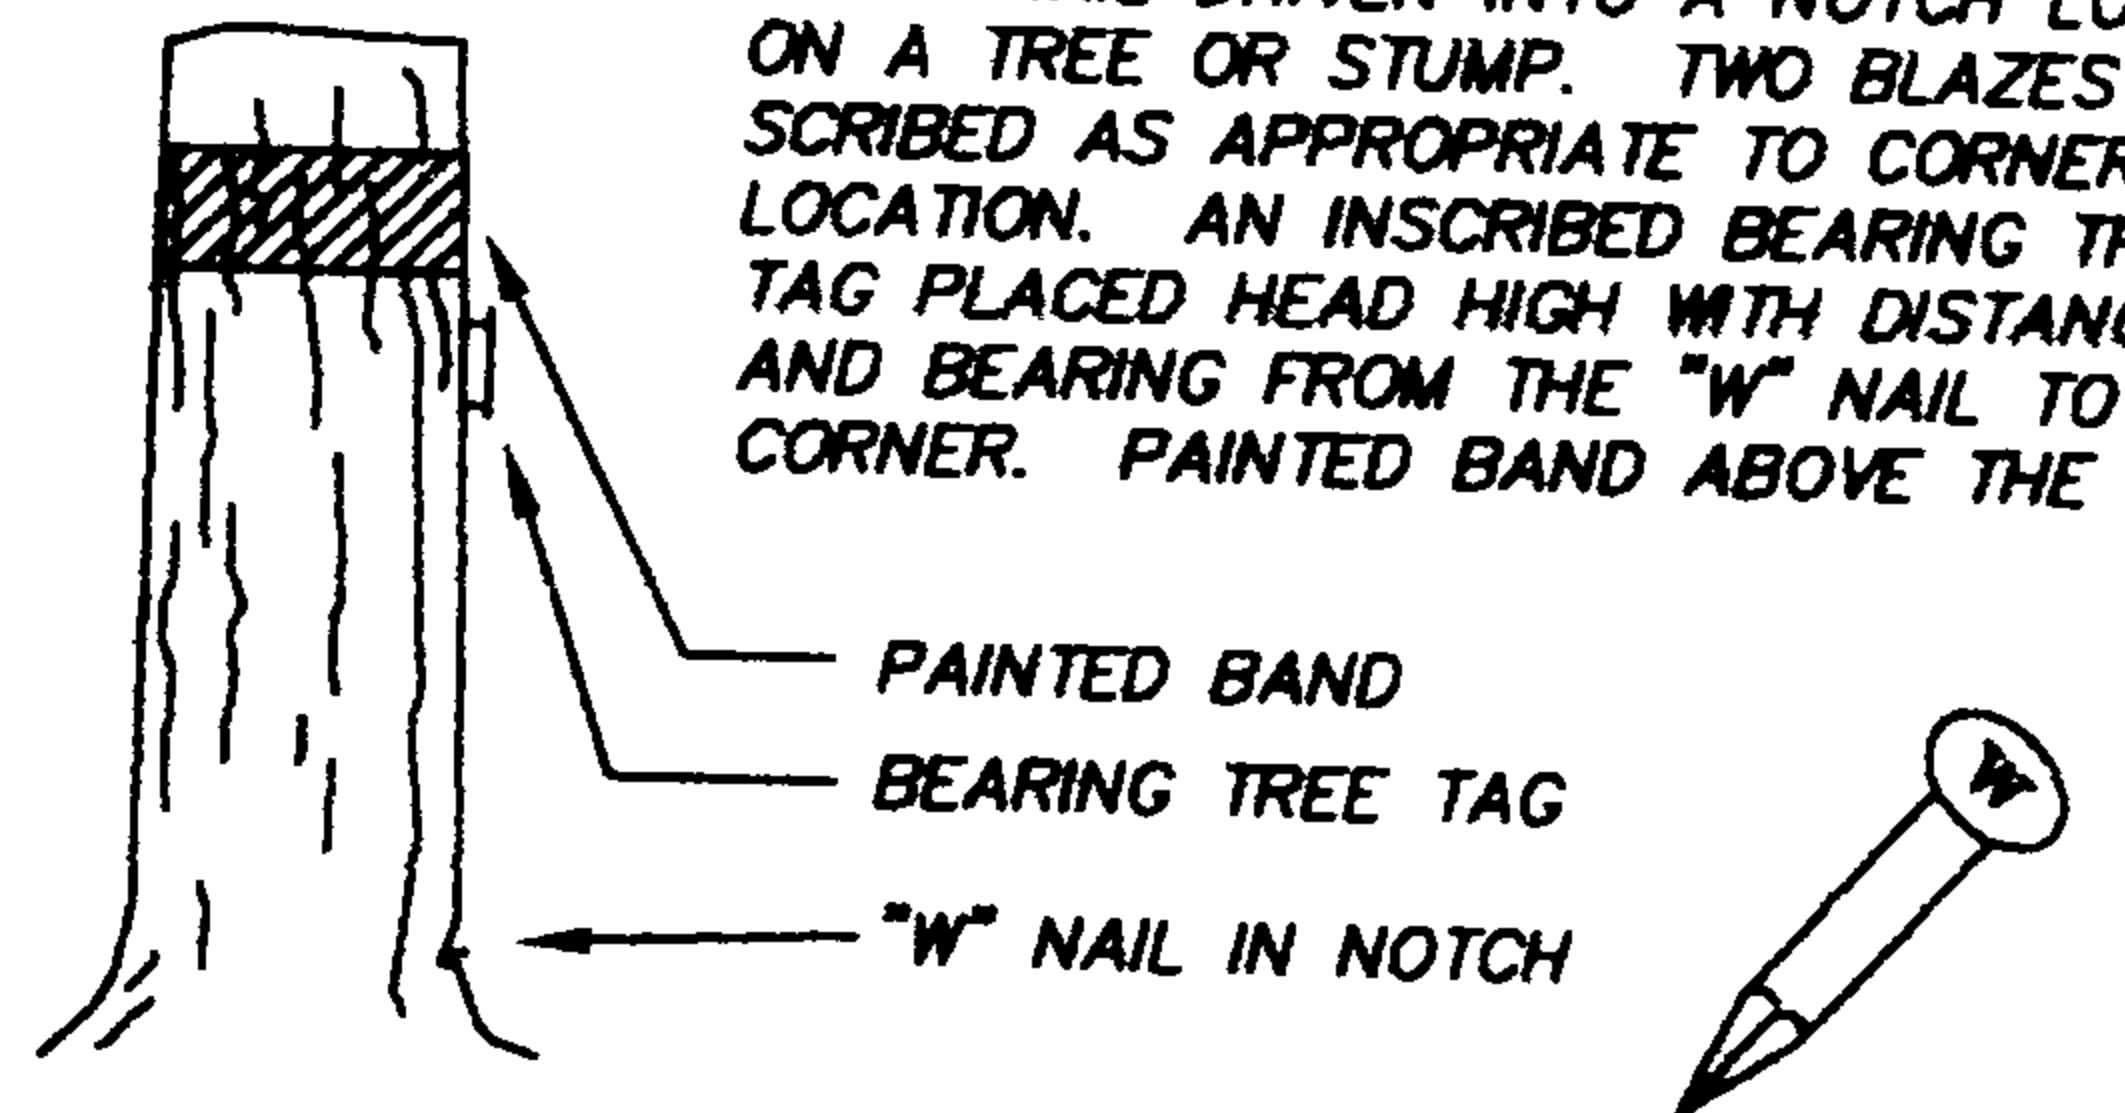

IDENTIFIED ON PHOTO: \_\_\_\_\_

INFORMATION ON CORNER AS NOW SET

GROUND COVER: NEW CLEARCUT, VINE MAPLE

SLOPE FACE (BEARING) N 23 E (-) 60 %

FROM CORNER NORTH -60% FOR 8 FEET TO CREEK FLOWING N 70 E

SOUTH +60% FOR 40 FEET TO 2430 RD.

EAST -20%

WEST LEVEL

BY: DAVID WELLMAN DATE: 6/26/03

FIRM: D. WELLMAN SURVEYING

ASSISTED BY: ERIN HEATHERSTONE

MICAH JOHNSTONE

COPIES TO: DOUGLAS COUNTY

ORS 672-025

REGISTERED PROFESSIONAL LAND SURVEYOR

*David H. Wellman*

OREGON  
JULY, 1985  
DAVID H. WELLMAN  
2163

RENEWAL 6/30/04