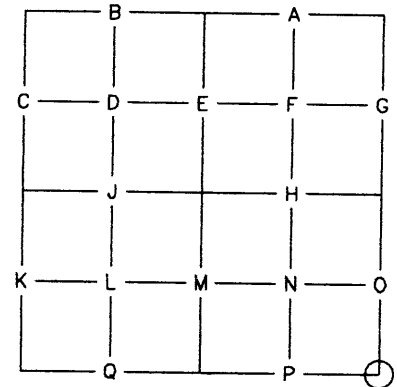


PUBLIC LAND CORNER

INDEX NO. 200200WEYERHAEUSER COMPANY
WILLAMETTE REGION

TOWNSHIP 23 SOUTH RANGE 3 WEST
 SECTION 30 CORNER SE SECTION
 COUNTY DOUGLAS OREGON

ORIGINAL CORNER DATED: 1882 BY: GLO - CURRIN
 CORNER: 5" YEW
 ACCESSORIES: 28" CEDAR, N 40 E, 45 LKS.
6" HEMLOCK, S 55 E, 34 LKS.
40" HEMLOCK, S 3 W, 65 LKS.
30" HEMLOCK, N 25 W, 40 LKS.

RE-ESTABLISHMENT NOTES DATED: 1954 BY: GARDNER - C.S. 53/1
 EVIDENCE RECOVERED: SW HEMLOCK - SCRIBING VISIBLE, CEDAR AND NE HEMLOCK LOCATED
HEMLOCK NEARLY DEAD STILL STANDING - SCRIBING VISIBLE
 CORNER SET: _____
 ACCESSORIES ESTABLISHED: 16" CEDAR, N 74 W, 52.5 FEET - MARKED "S30 BT"
32" CEDAR, S 28 W, 65.0 FEET - MARKED "S32 BT"
18" HEMLOCK, ? 30 W, 51.4 FEET - MARKED "S31 BT"
20" CEDAR, N 27 E, 80.5 FEET


RE-ESTABLISHMENT NOTES DATED: 1967 BY: DOUGLAS COUNTY
 EVIDENCE RECOVERED: 53" CEDAR STUMP, N 40 E, 29.7 FEET
18" HEMLOCK, S 49 E, 22.4 FEET - DOUGLAS CO. SCRIBE "T23S R3W S32 CS BT"
50" HEMLOCK STUMP, S 3 W, 42.9 FEET - SCRIBING VISIBLE
42" HEMLOCK STUMP, N 25 W, 26.4 FEET - SCAR VISIBLE
32" CEDAR STUMP, S 32 E, 65.0 FEET - SCRIBING VISIBLE
20" CEDAR, N 27 E, 81.7 FEET - SCRIBING VISIBLE

CORNER SET: 1-3/4" IRON PIPE WITH 1967 DOUGLAS COUNTY BRASS CAP - 0.3 FEET AGL
 ACCESSORIES ESTABLISHED: 6 FOOT METAL FENCE POST ALONG SIDE OF CAP


REMONUMENTATION

DATE: 6/26/03 BY: DAVID WELLMAN TITLE: PLS 2163 FIRM: D. WELLMAN SURVEYING
 EVIDENCE RECOVERED: 1-3/4" IRON PIPE WITH 1967 DOUGLAS CO. BRASS CAP - 0.3 FEET AGL
53" CEDAR STUMP, N 44 E, 31.1 FEET TO SPIKE SET SIDE CENTER - NEW WAYCO TAG SET
26" HEMLOCK, S 45 E, 23.7 FEET TO SPIKE SET SIDE CENTER - NEW WEYCO TAG SET
50" HEMLOCK STUMP, 1967 DOUGLAS CO. TAG READS "N 3 E, 42.9 FEET"
NW HEMLOCK BT FOUND ROTTEN
32" CEDAR STUMP, 1967 DOUGLAS CO. TAG READS "N 32 W, 65.0 FEET"
21" CEDAR, 1967 DOUGLAS CO. TAG READS "S 27 W, 81.7 FEET"
 CORNER SET: _____
 ACCESSORIES ESTABLISHED: 26" FIR, N 55 W, 9.1 FEET TO SPIKE SET SIDE CENTER
SCRIBED "S 30 BT"
 OTHER INFORMATION: _____

SECTION 30 TOWNSHIP 23 S RANGE 3 W

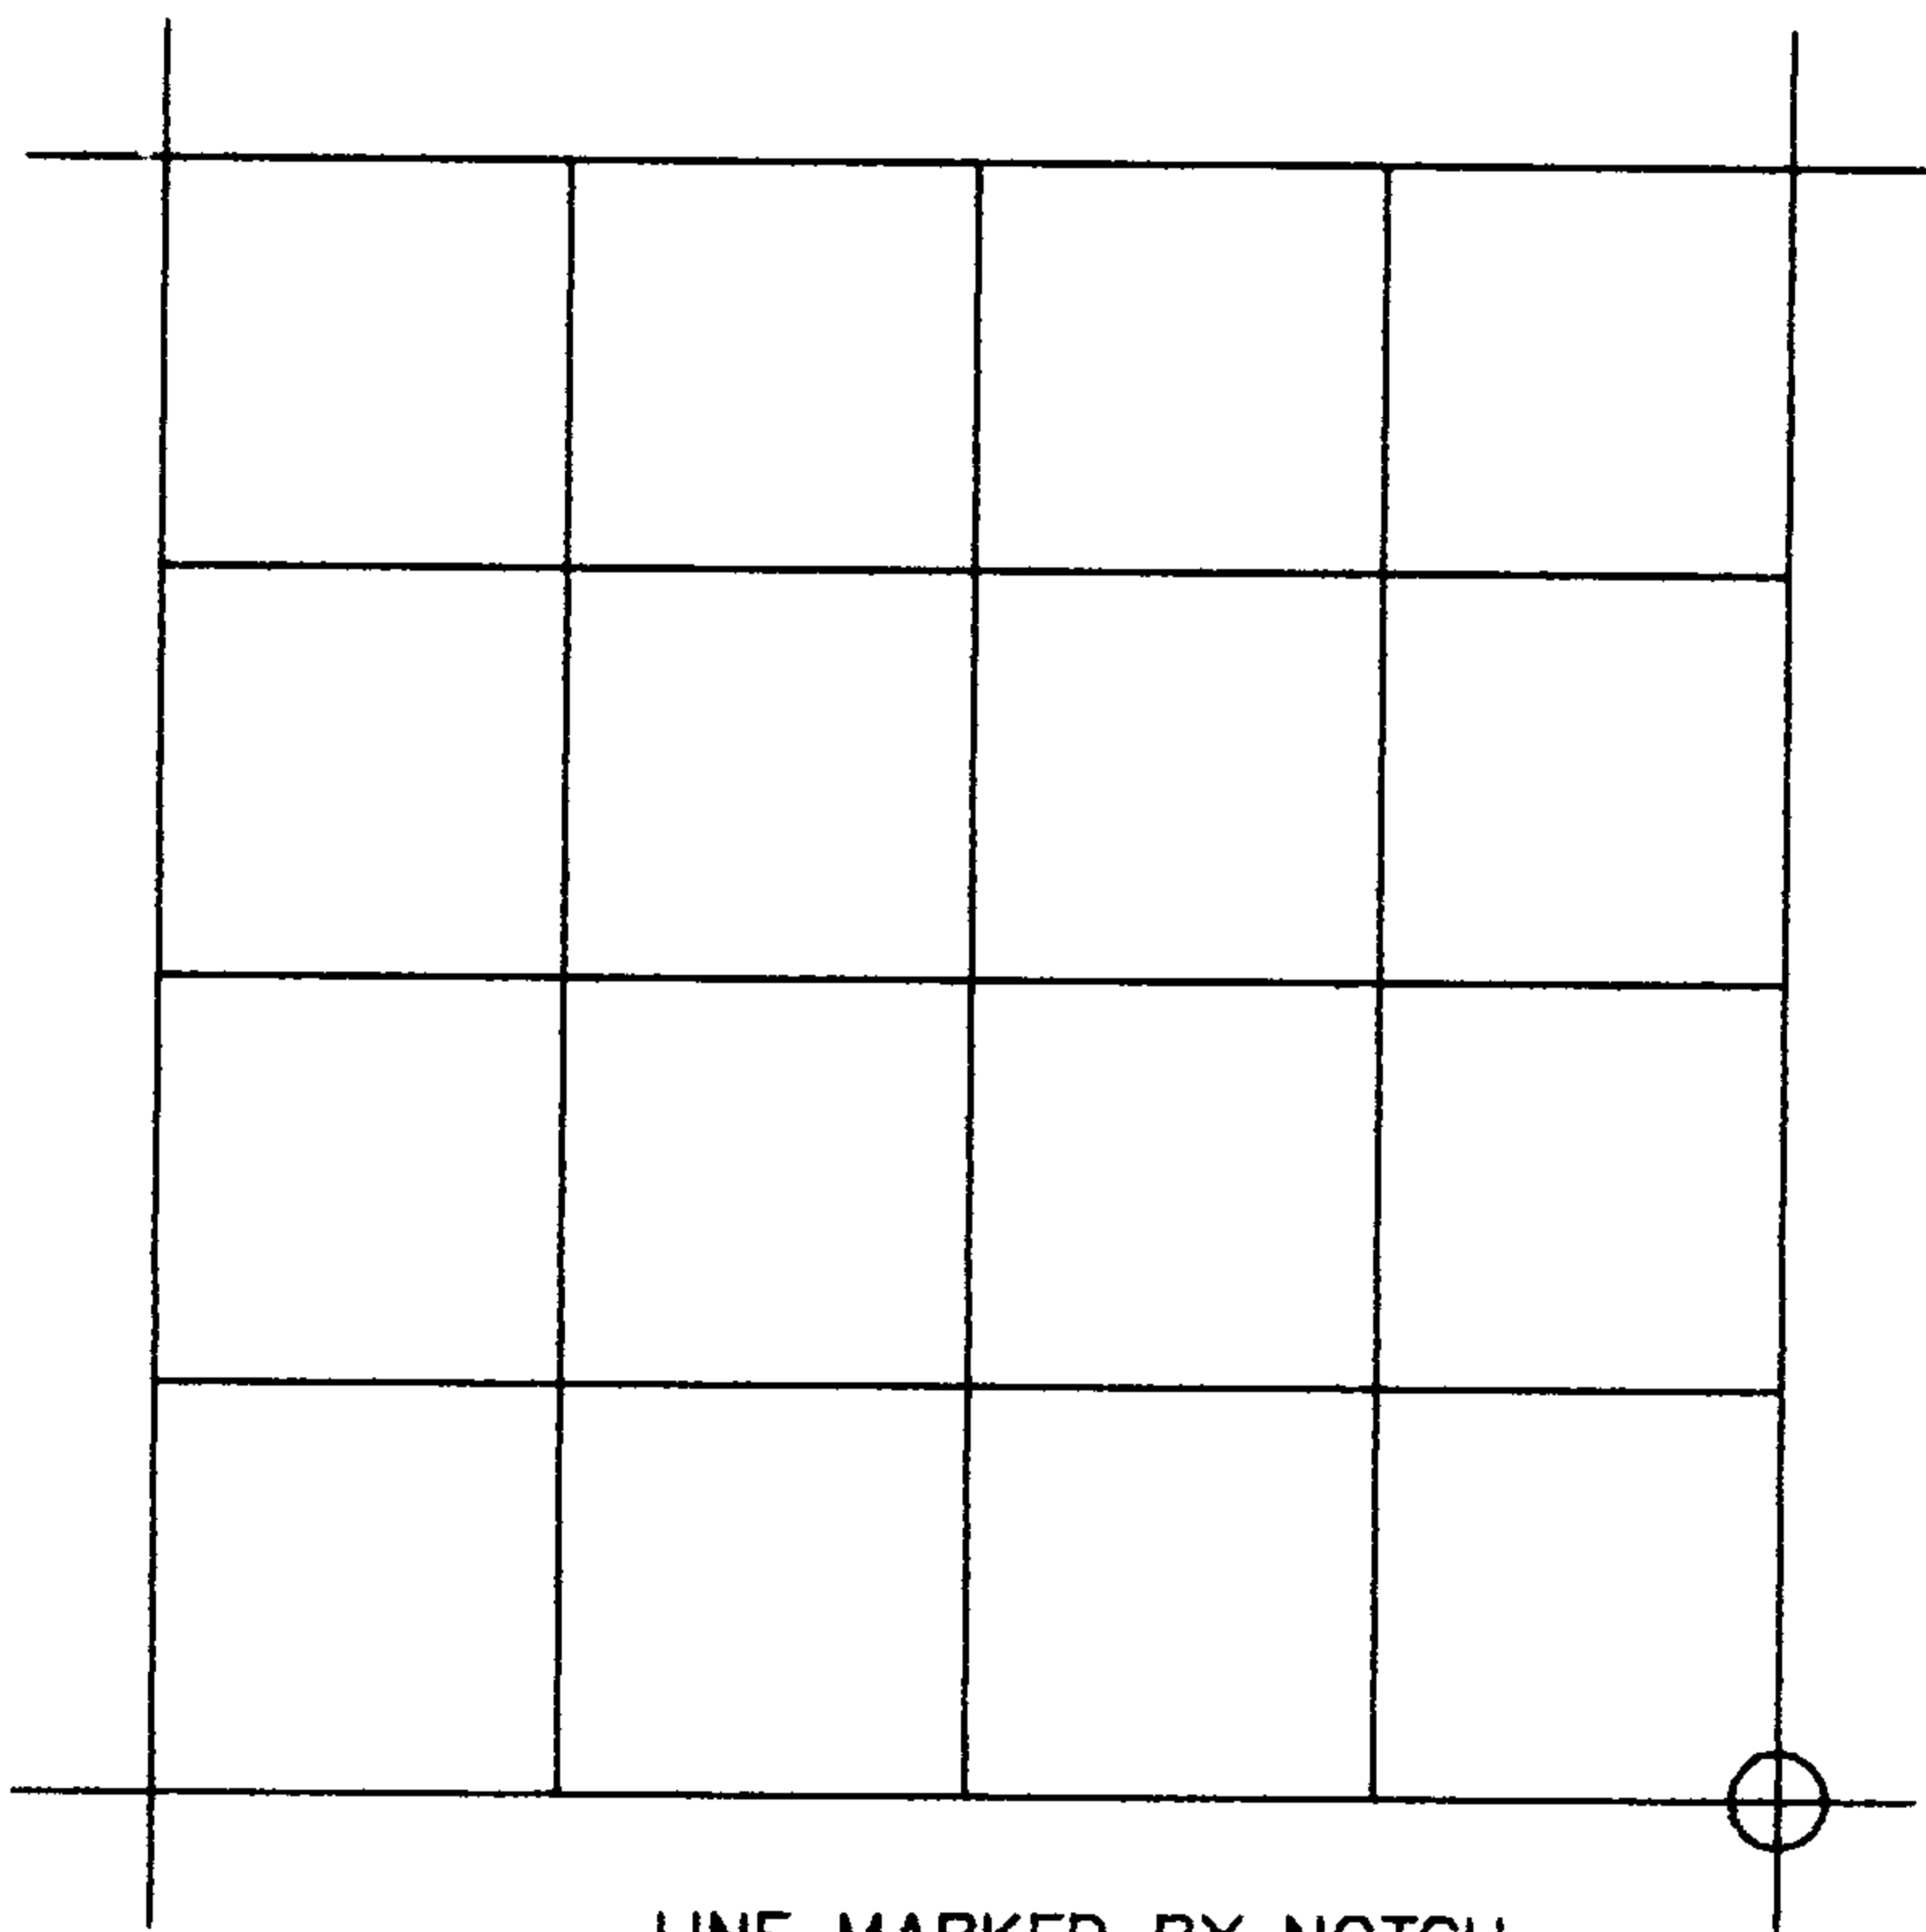

SKETCH

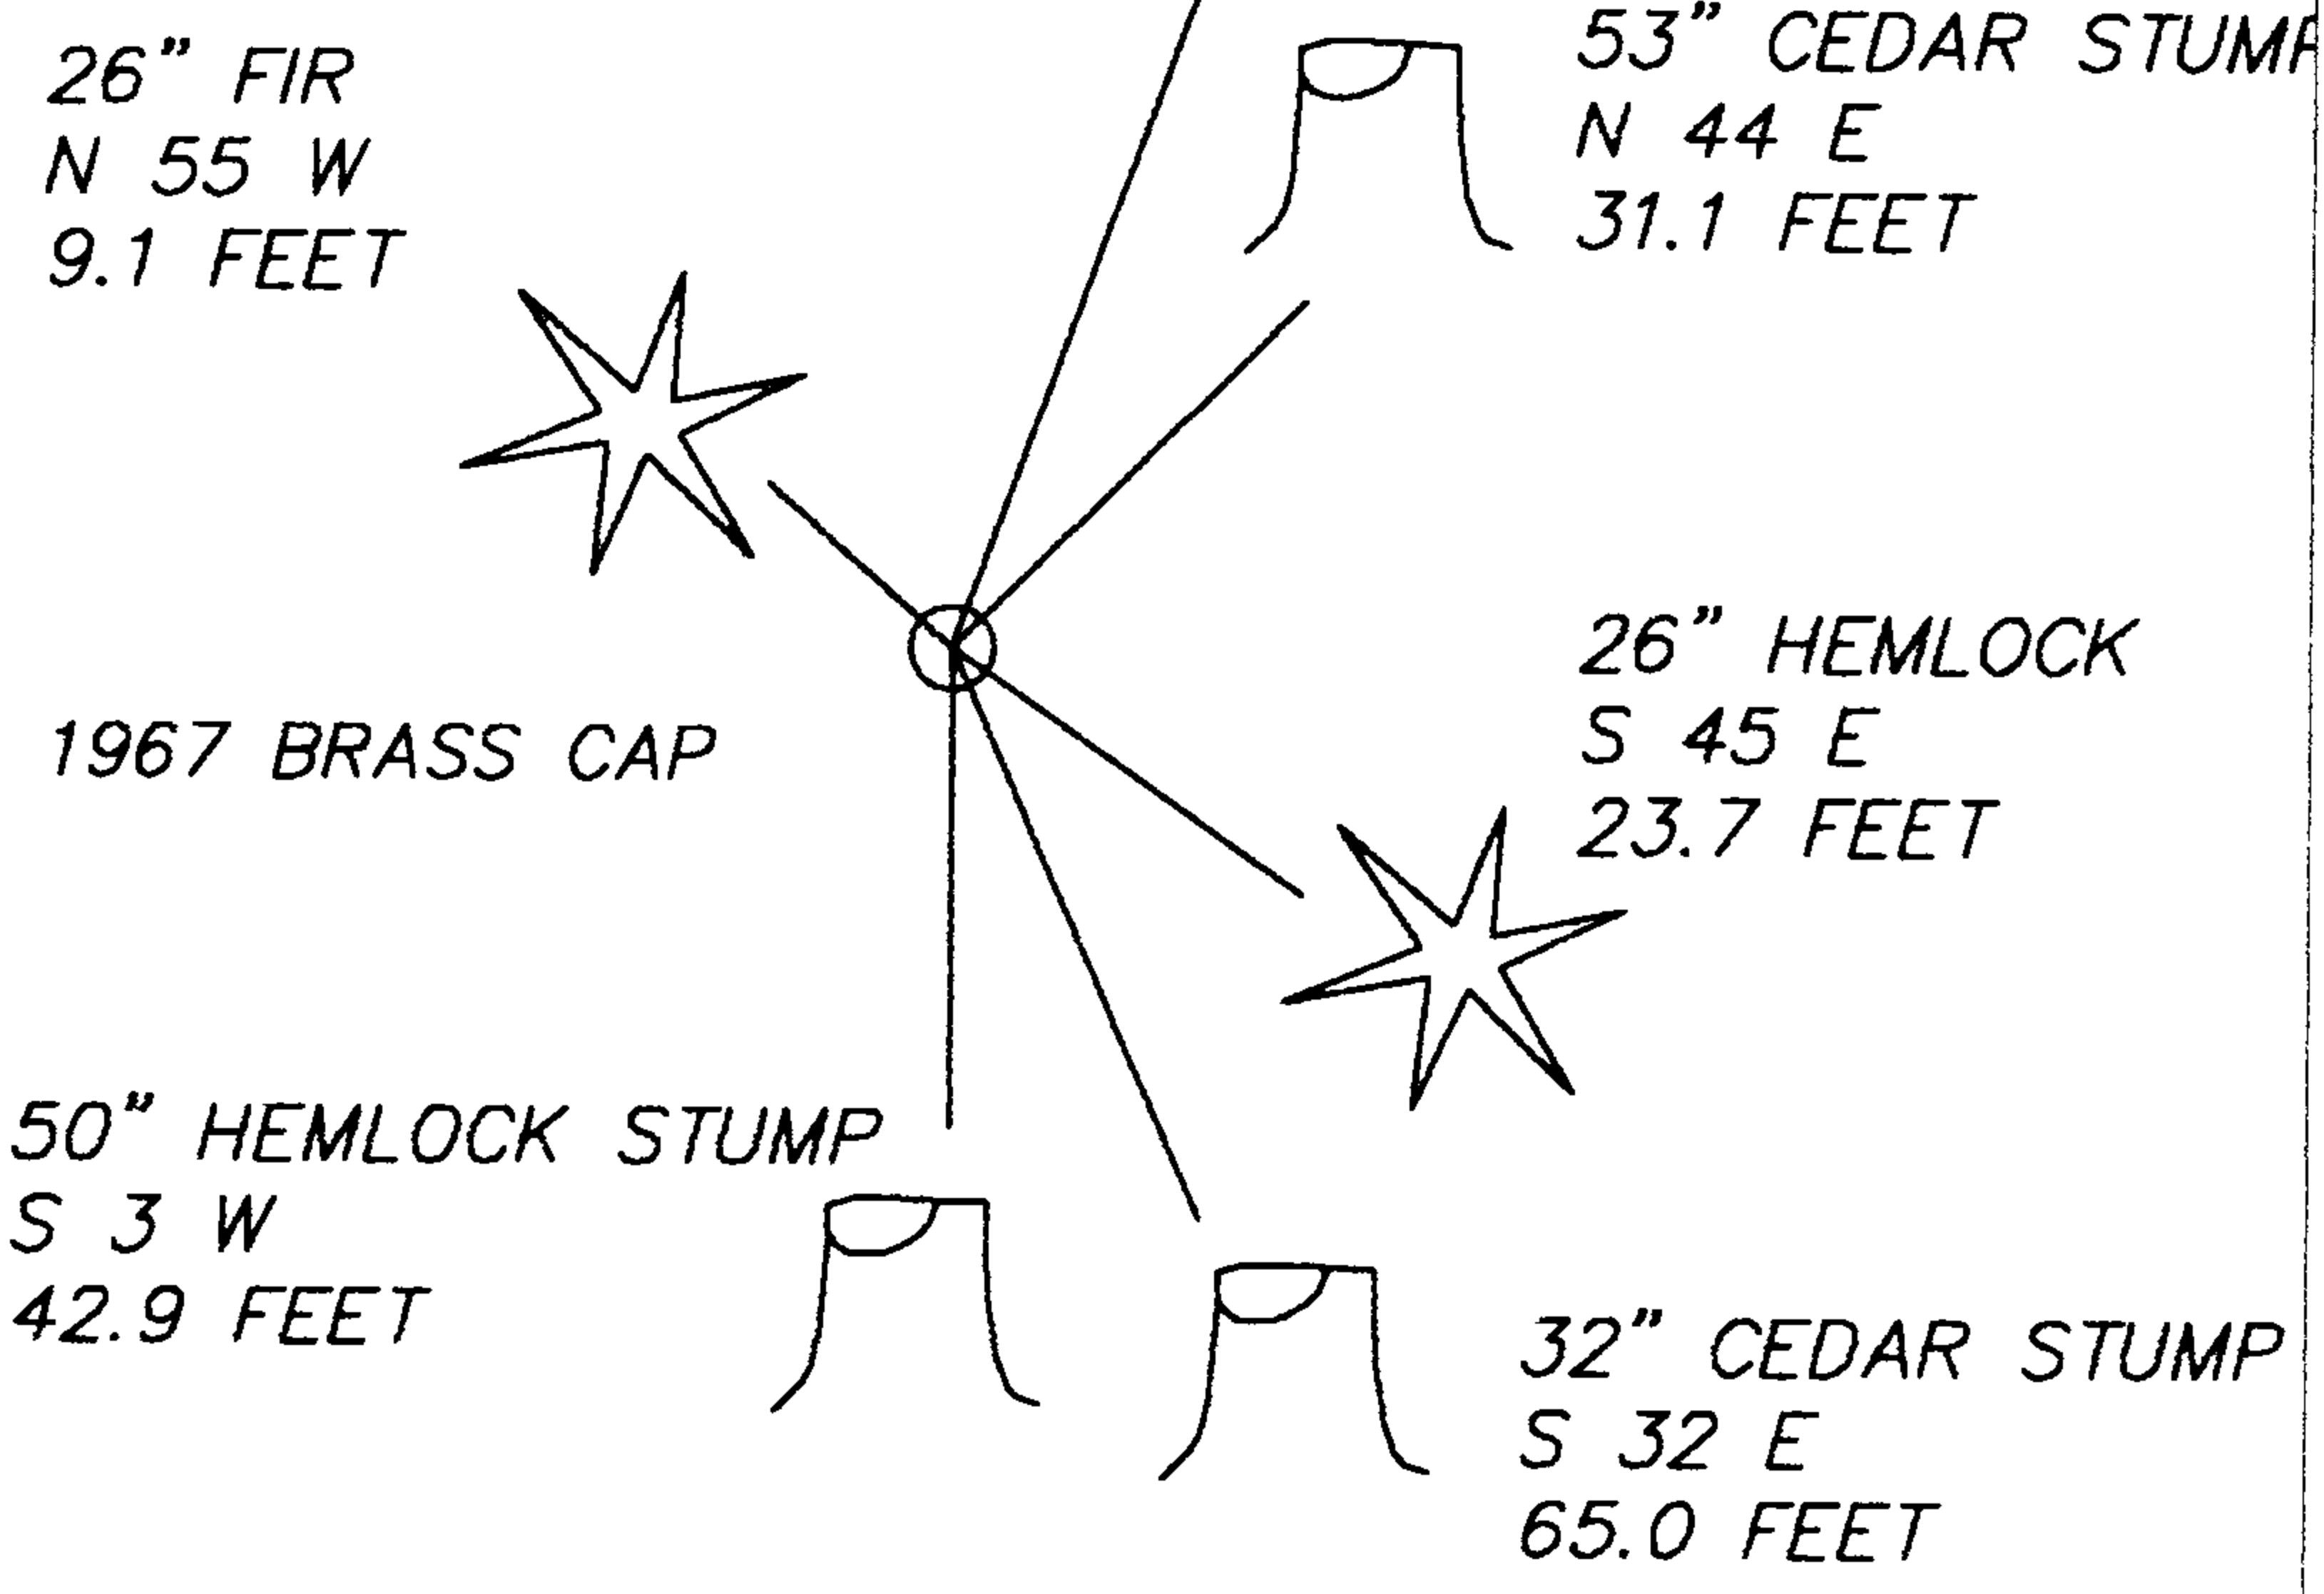


- // LINE MARKED BY NOTCH CUT IN BLAZE
- KNOWN CORNER
- ⊗ REFERENCED CORNER BY WEYERHAEUSER METHOD

CORNER LIES APPROX. 150 FEET WEST OF A RAVINE

WEYERHAEUSER COMPANY
CORNER REFERENCE METHOD

A "W" NAIL DRIVEN INTO A NOTCH LOW ON A TREE OR STUMP. TWO BLAZES SCRIBED AS APPROPRIATE TO CORNER LOCATION. AN INSCRIBED BEARING TREE TAG PLACED HEAD HIGH WITH DISTANCE AND BEARING FROM THE "W" NAIL TO THE CORNER. PAINTED BAND ABOVE THE TAG.

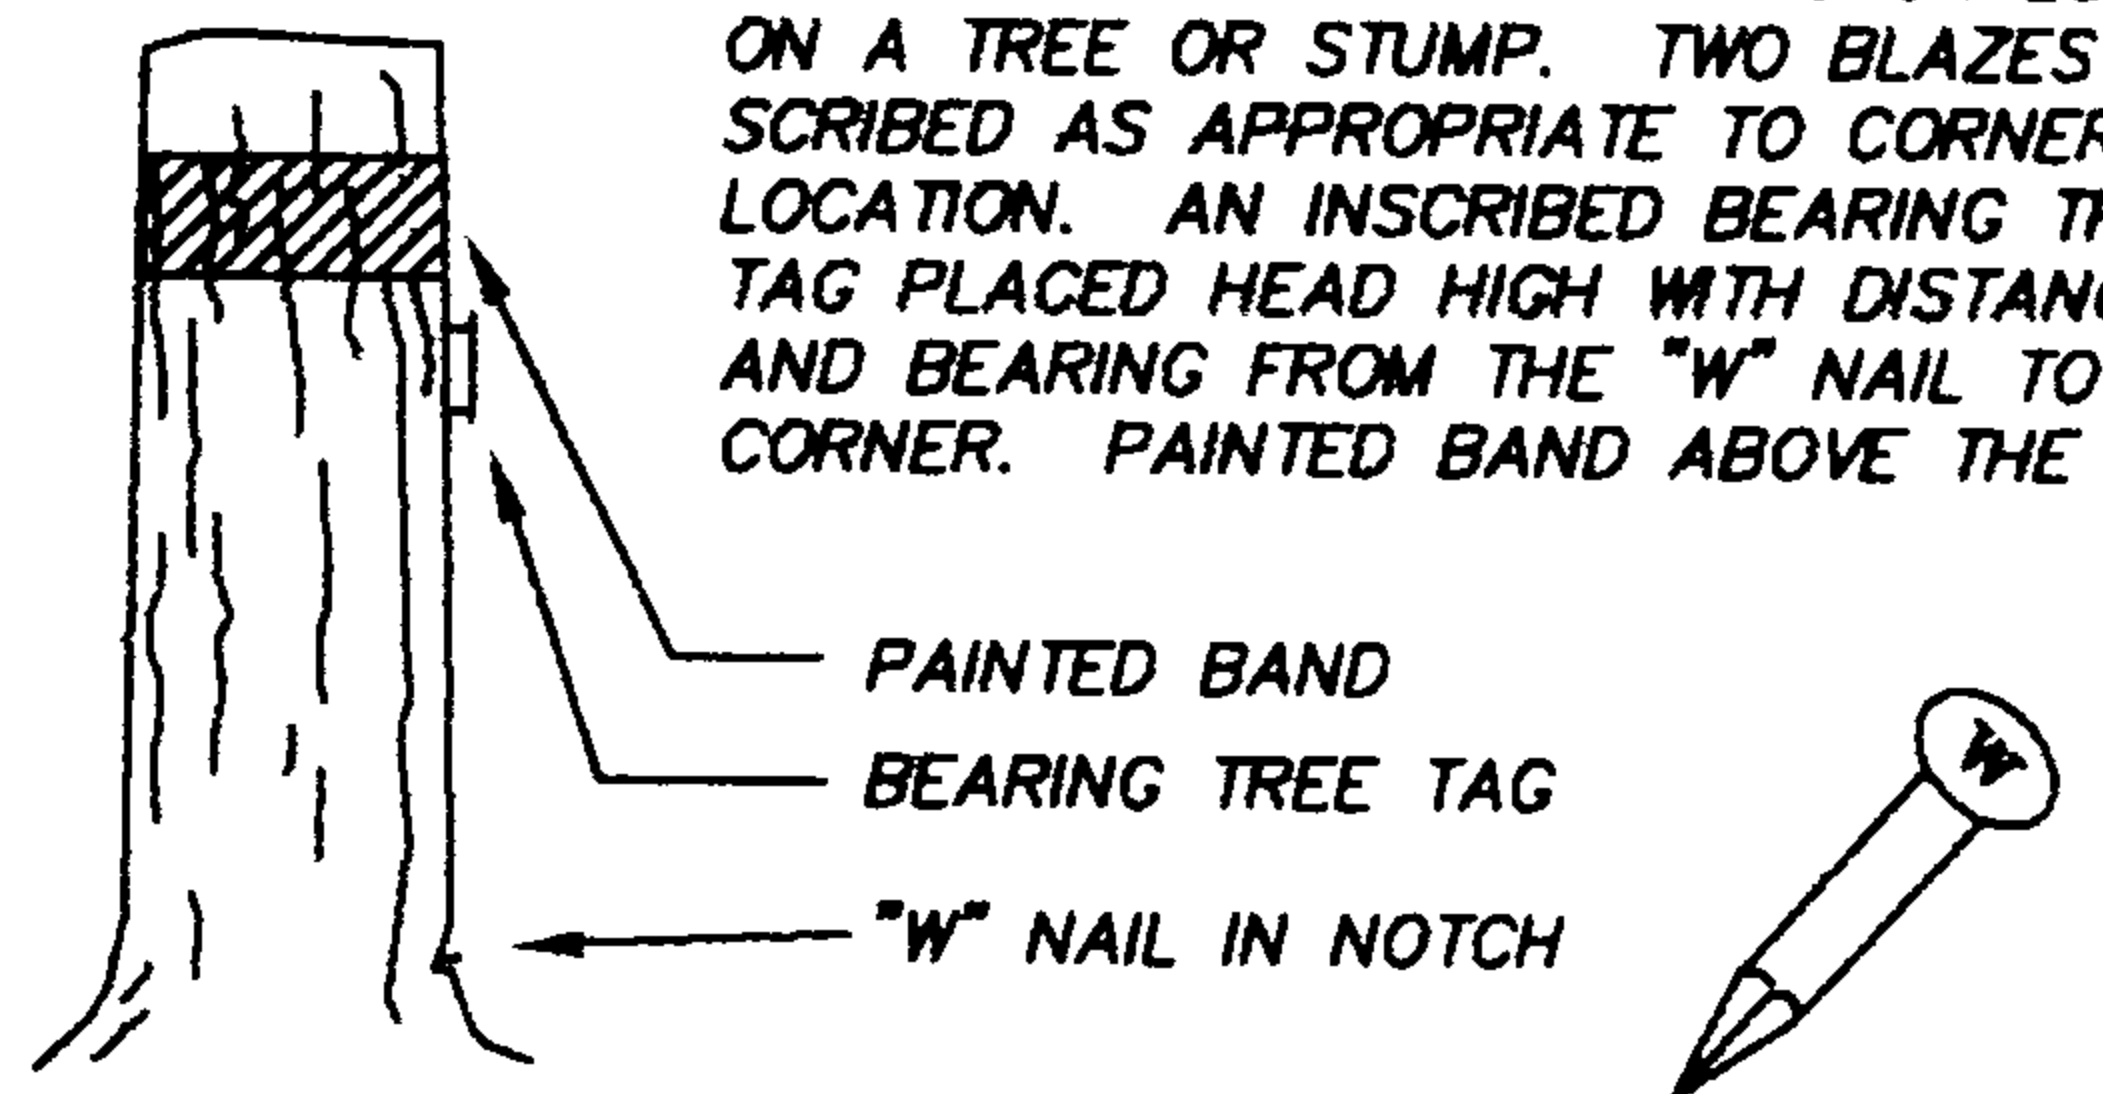

IDENTIFIED ON PHOTO: _____

INFORMATION ON CORNER AS NOW SET
GROUND COVER: FIR AND HEMLOCK TO 27", SWORD FERN
SLOPE FACE (BEARING) N 75 E (-) 35 %

FROM CORNER

NORTH	<u>-13%</u>
SOUTH	<u>+17%</u>
EAST	<u>-30% FOR 30' THEN -55% TO BOTTOM OF RAVINE</u>
WEST	<u>+25%</u>

BY: DAVID WELLMAN DATE: 6/26/03
FIRM: D. WELLMAN SURVEYING
ASSISTED BY: ERIN HEATHERSTONE
MICAH JOHNSTONE
COPIES TO: DOUGLAS COUNTY

ORS 672-025

REGISTERED PROFESSIONAL LAND SURVEYOR

David H. Wellman

OREGON
JULY, 1985
DAVID H. WELLMAN
2163

RENEWAL 6/30/04