


PUBLIC LAND CORNER

INDEX NO. 500140

WEYERHAEUSER COMPANY WILLAMETTE REGION

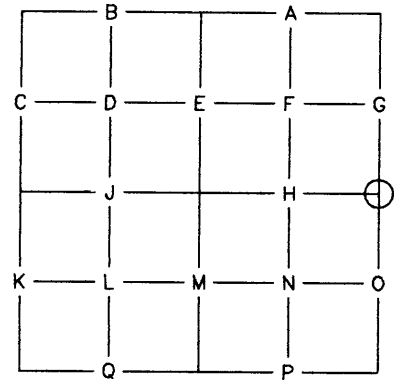

TOWNSHIP 23 SOUTH RANGE 3 WEST
 SECTION 34 CORNER EAST 1/4
 COUNTY DOUGLAS OREGON

ORIGINAL CORNER DATED: 1882 BY: GLO - CURRIN
 CORNER: 12" FIR - MARKED 1/4 S ON WEST FACE
 ACCESSORIES: 10" YEW, S 80 W, 15 LKS.
12" FIR, N 30 E, 4 LKS.

RE-ESTABLISHMENT NOTES DATED: 1958 BY: WEYERHAEUSER CO.
 EVIDENCE RECOVERED: 12" FIR - MARKED 1/4 S ON WEST FACE
24" YEW, S 80 W, 9.9 FEET
16" FIR SNAG, N 30 E, 2.6 FEET - SCRIBING VISIBLE

CORNER SET: _____
 ACCESSORIES ESTABLISHED: 60" FIR, N 51 E, 52.4 FEET TO "W" NAIL
60" FIR, S 86 W, 42.9 FEET TO "W" NAIL


RE-ESTABLISHMENT NOTES DATED: _____ BY: _____
 EVIDENCE RECOVERED: _____

CORNER SET: _____
 ACCESSORIES ESTABLISHED: _____

REMONUMENTATION


DATE: 6/26/03 BY: DAVID WELLMAN TITLE: PLS 2163 FIRM: D. WELLMAN SURVEYING
 EVIDENCE RECOVERED: 1/2" MONEL PIPE
60" FIR STUMP, WEYCO TAG READS "S 51 W, 52.4 FEET"
60" FIR STUMP, S 86 W, 42.9 FEET TO FACE
 CORNER SET: 1-3/4"X36" IRON PIPE WITH 2-1/2" BRASS CAP DATED 2003 SET OVER TOP OF MONEL PIPE - 1.2 FEET AGL
 ACCESSORIES ESTABLISHED: 13" FIR, S 49 E, 6.3 FEET TO SPIKE SET SIDE CENTER
SCRIBED "1/4 S35 BT"
11" FIR, S 33-1/2 W, 4.4 FEET TO SPIKE SET SIDE CENTER - SCRIBED "1/4 S34 BT"
13" FIR, N 33 E, 32.0 FEET TO SPIKE SET SIDE CENTER - SCRIBED "1/4 S35 BT"
14" FIR, N 38 W, 31.2 FEET TO SPIKE SET SIDE CENTER - SCRIBED "1/4 S34 BT"

SECTION 34 TOWNSHIP 23 S RANGE 3 W

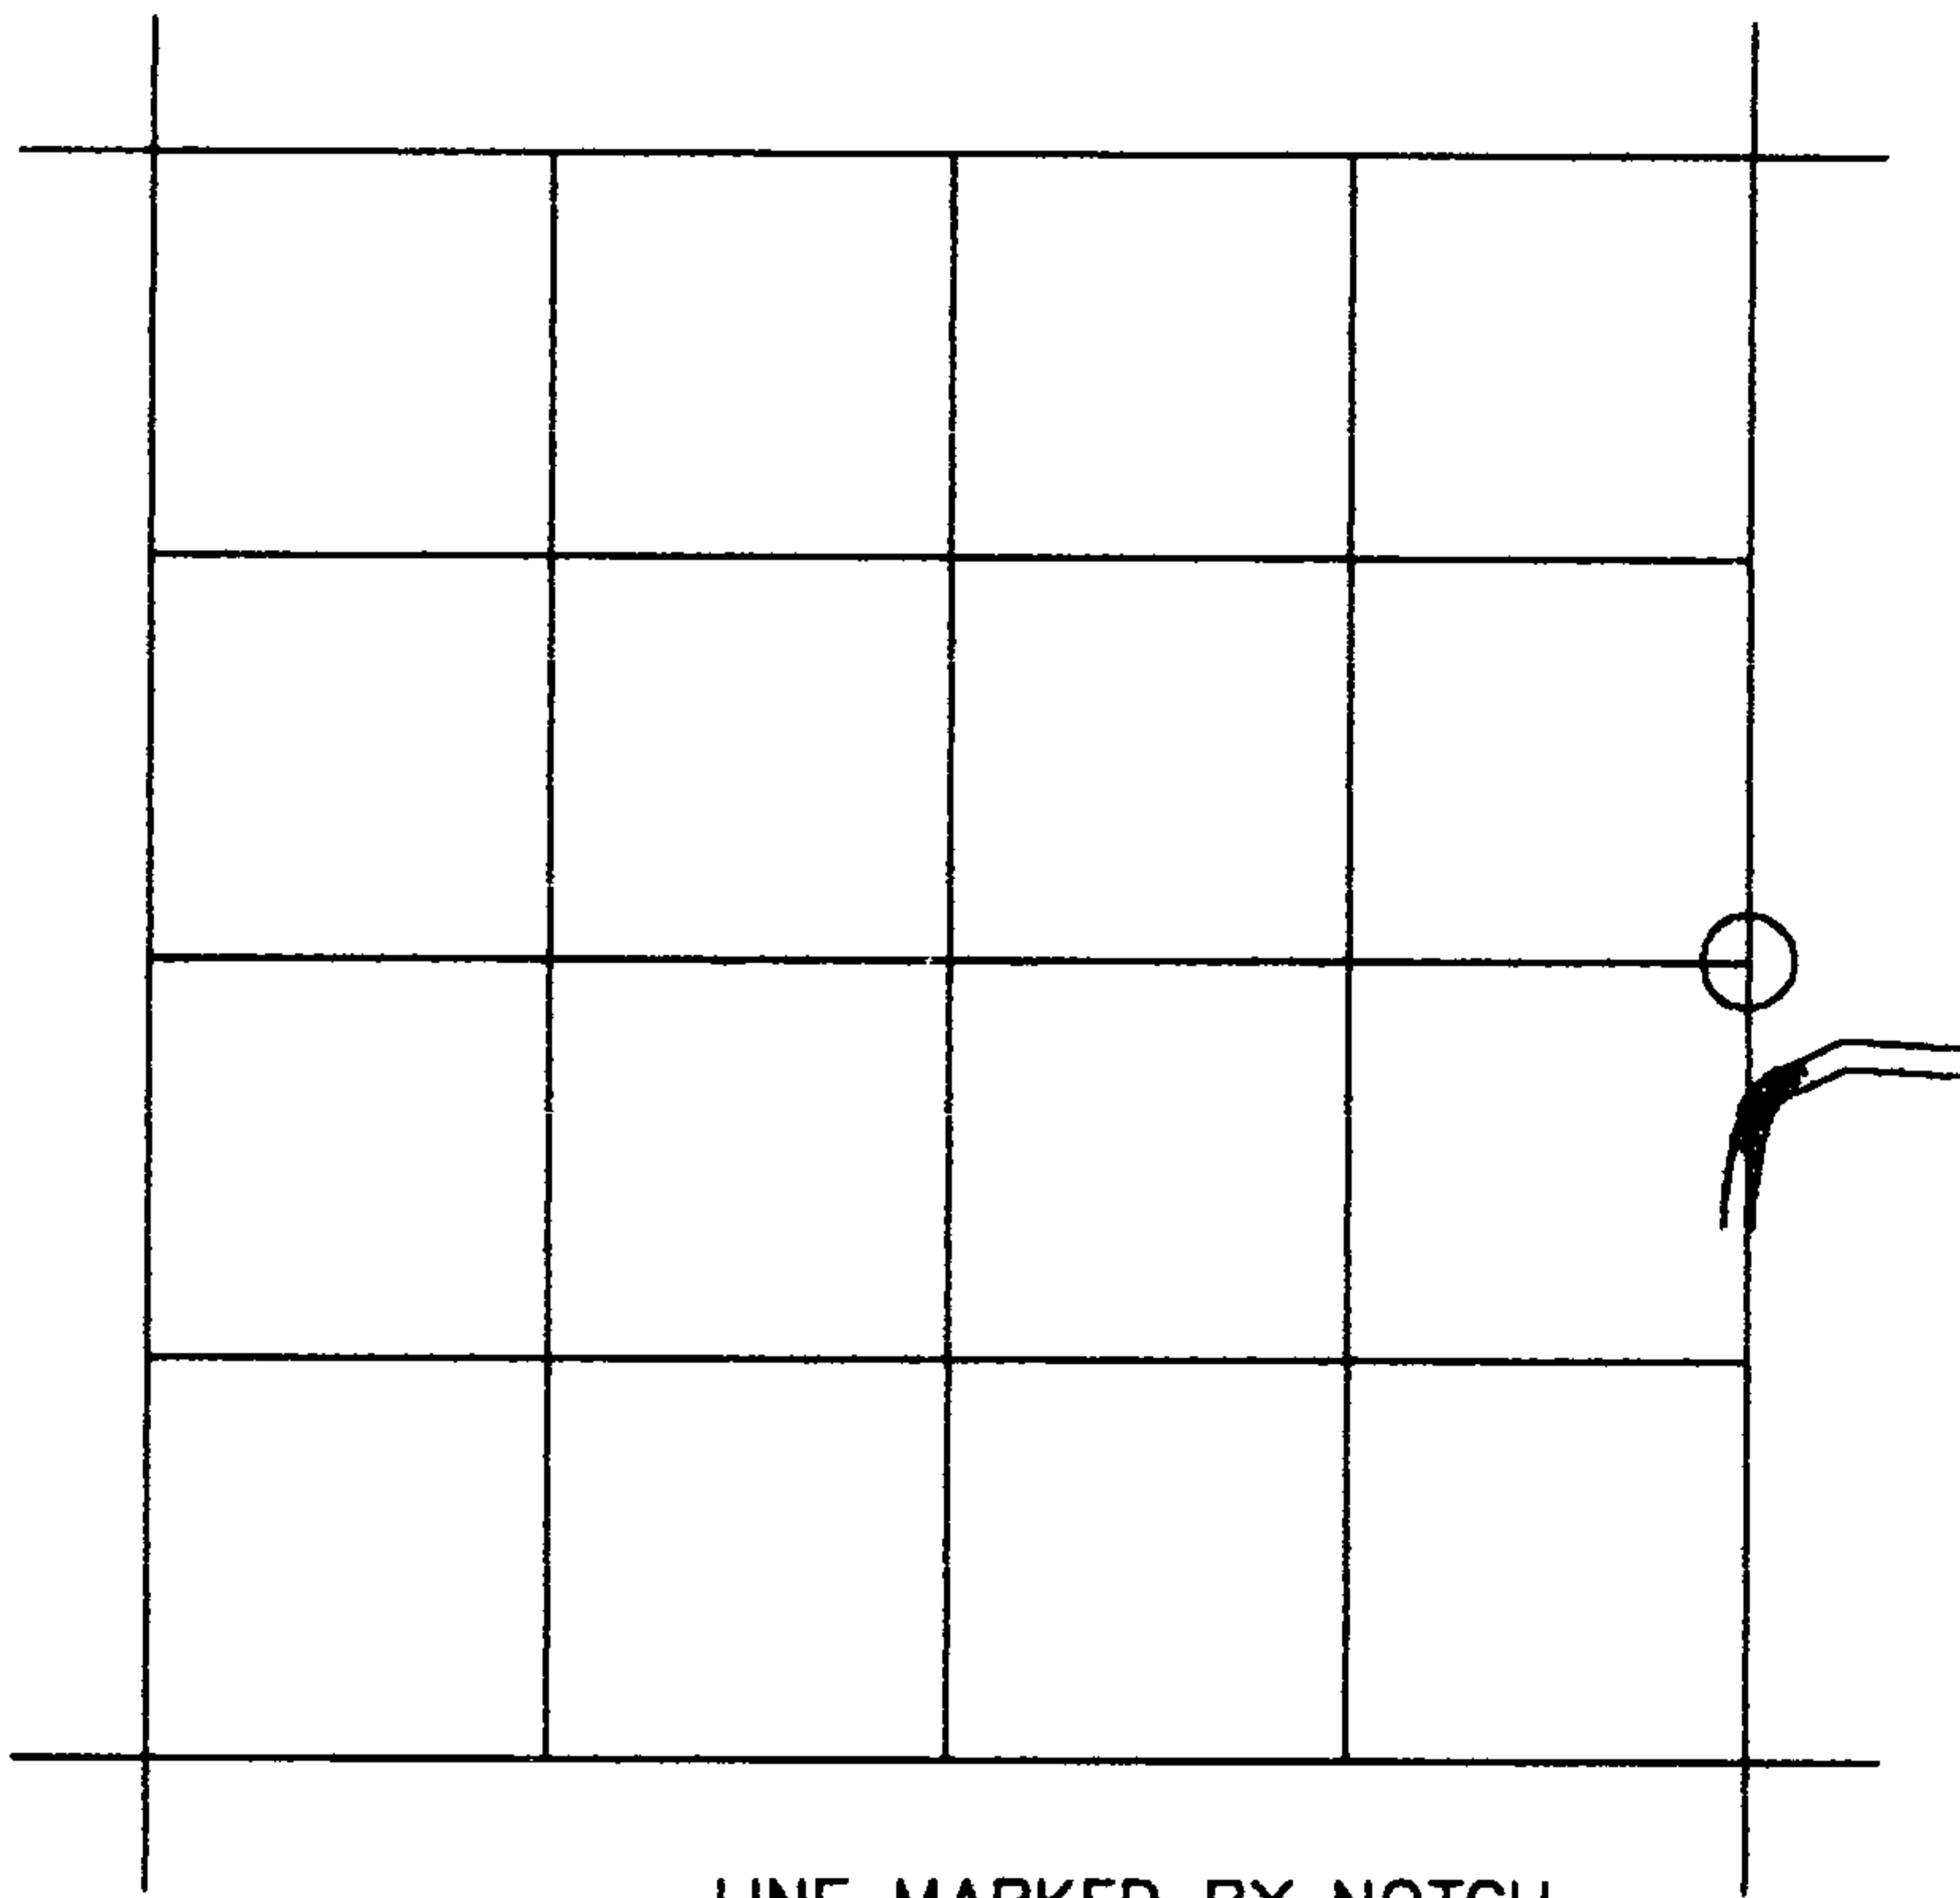

- LINE MARKED BY NOTCH CUT IN BLAZE
- KNOWN CORNER
- REFERENCED CORNER BY WEYERHAEUSER METHOD

SKETCH

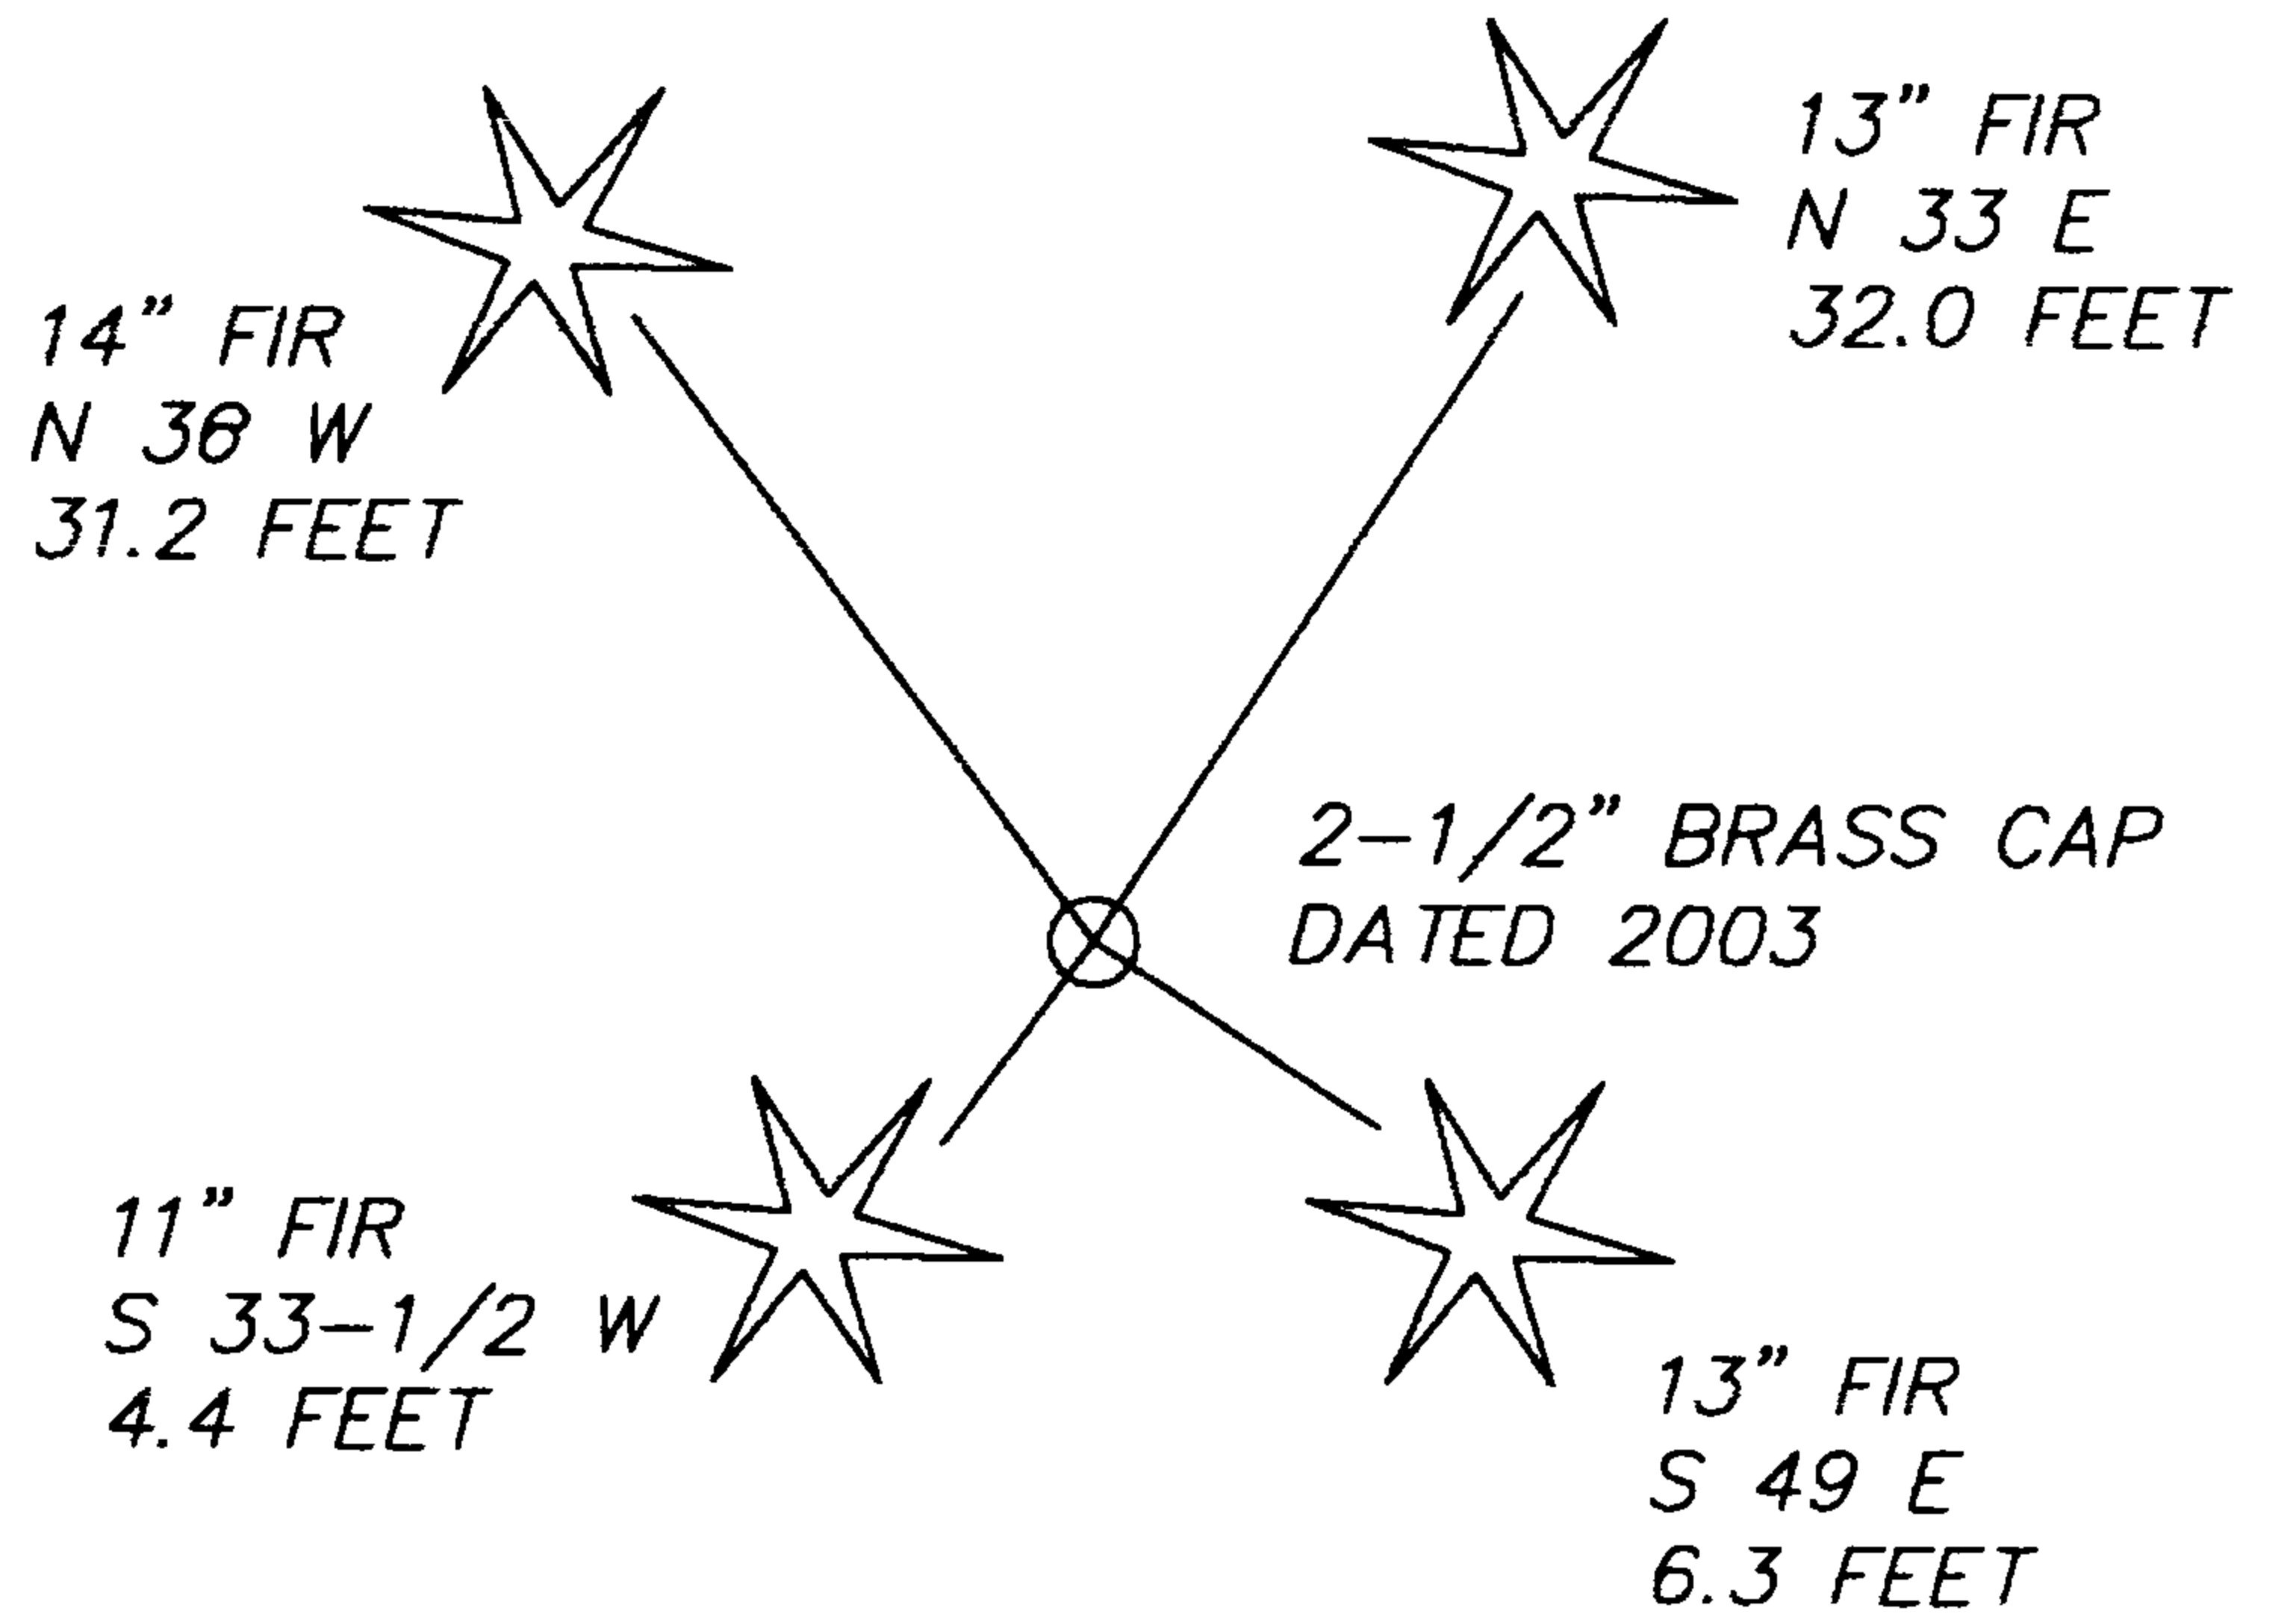


CORNER IS APPROX. 100' NORTH OF 535 RD.

WEYERHAEUSER COMPANY

CORNER REFERENCE METHOD

A "W" NAIL DRIVEN INTO A NOTCH LOW ON A TREE OR STUMP. TWO BLAZES SCRIBED AS APPROPRIATE TO CORNER LOCATION. AN INSCRIBED BEARING TREE TAG PLACED HEAD HIGH WITH DISTANCE AND BEARING FROM THE "W" NAIL TO THE CORNER. PAINTED BAND ABOVE THE TAG.

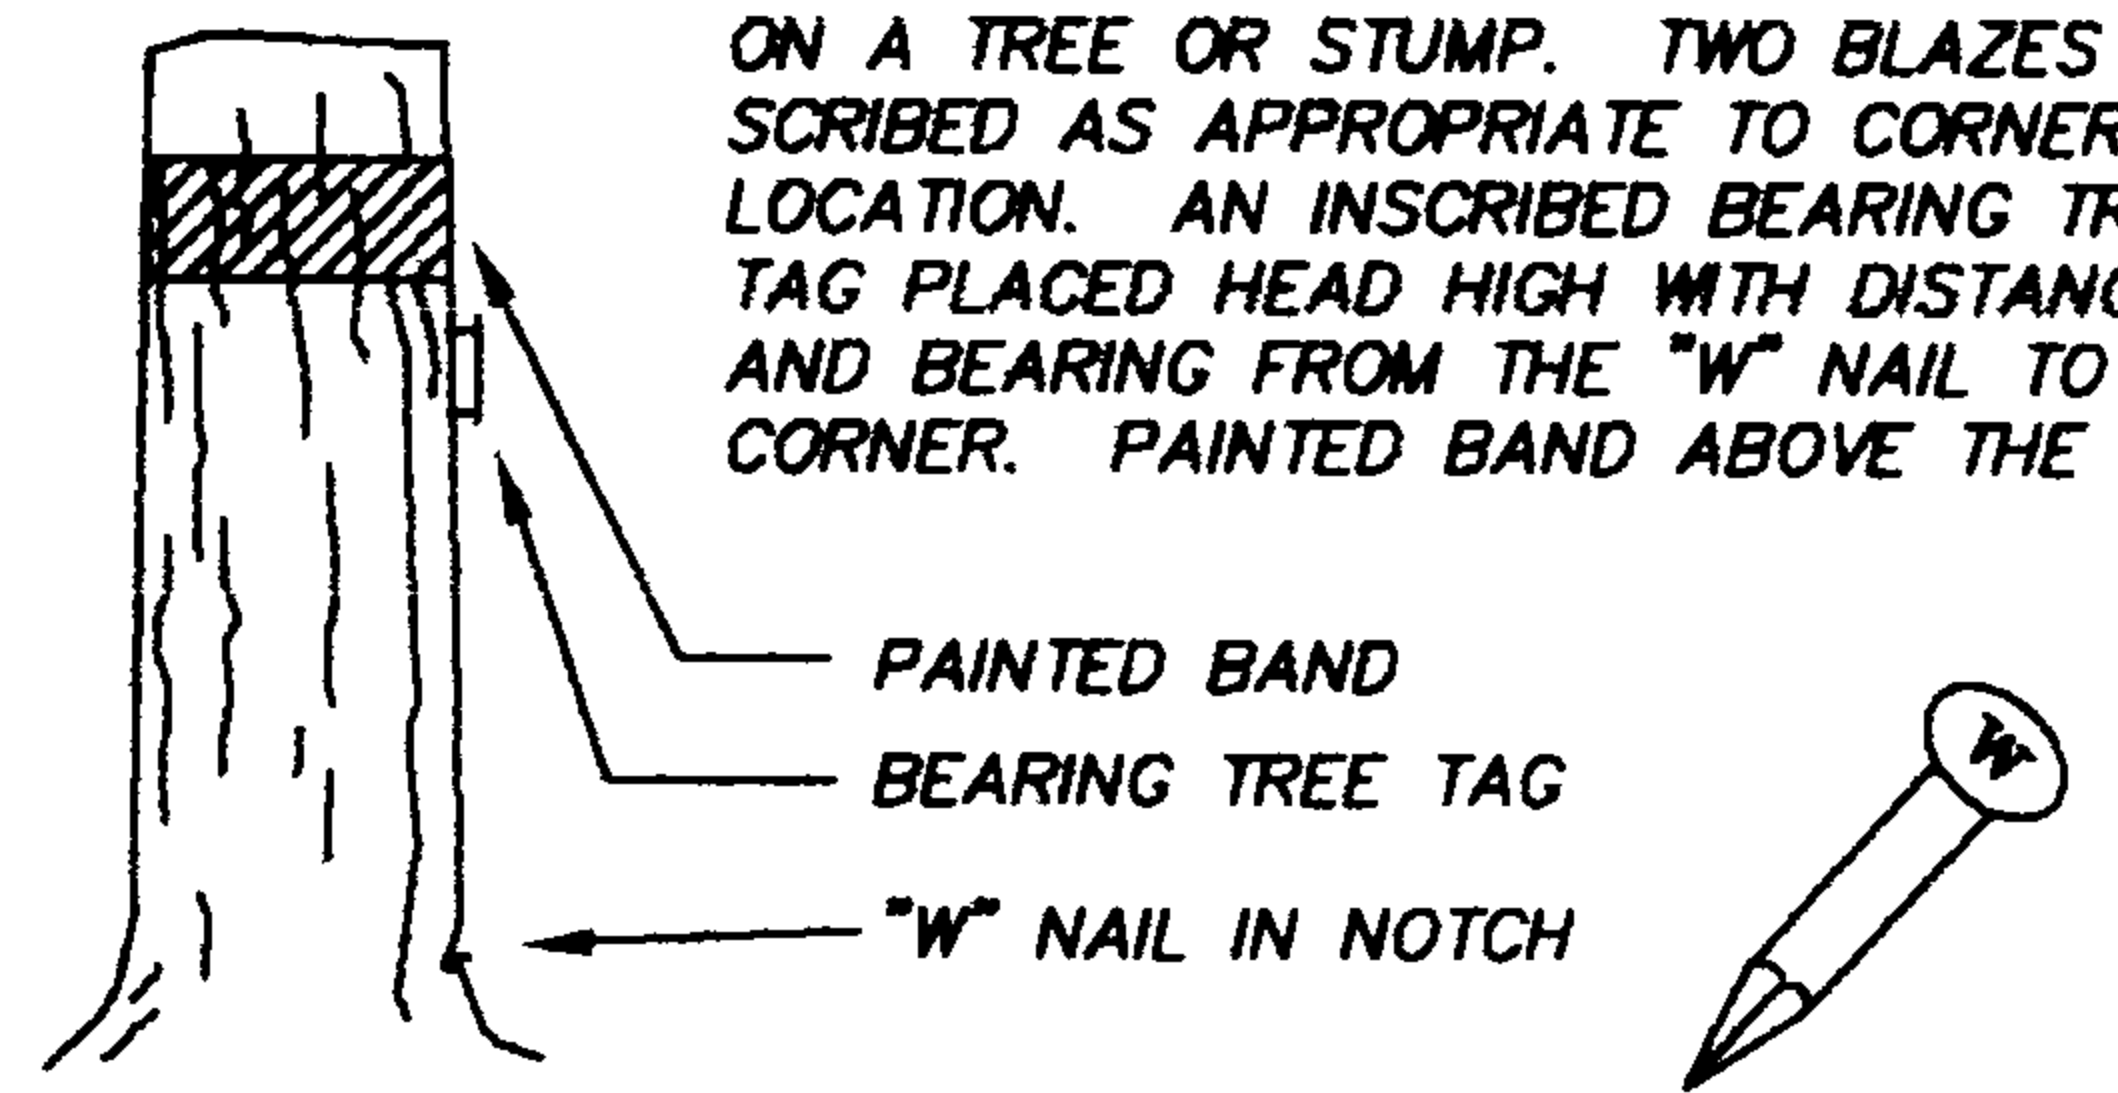

IDENTIFIED ON PHOTO: _____

INFORMATION ON CORNER AS NOW SET

GROUND COVER: FIR 11" TO 20", SWORD FERN

SLOPE FACE (BEARING) N 35 E (-) 65 %

FROM CORNER

NORTH -65%

SOUTH +70%

EAST -30%

WEST +18% FOR 40' TO RIDGE LINE

BY: DAVID WELLMAN DATE: 6/26/03

FIRM: D. WELLMAN SURVEYING

ASSISTED BY: ERIN HEATHERSTONE
MICAH JOHNSTONE

COPIES TO: LANE COUNTY

ORS 672-025

REGISTERED PROFESSIONAL LAND SURVEYOR

David H. Wellman

OREGON
JULY, 1985
DAVID H. WELLMAN
2163

RENEWAL 6/30/04