



LAND MARK

SURVEYING, INC.

MONUMENT REPORT

SOUTHEAST 1/4, SECTION 19, TOWNSHIP 30 SOUTH, RANGE 5 WEST OF THE WILLAMETTE MERIDIAN, DOUGLAS COUNTY OREGON.


The purpose of this report is to reference and make record of the discrepancy of the monument found at Engineers Station 351+17.52 per ODOT drawing 7B-32-14 and designated Point Number 1037 on record survey ST. HWY I5-13.

Basis of bearings for this report was established using found monuments per record survey ST. HWY I5-13 shown as Point Number 1050 (found 2 3/4" brass cap on 1 1/2" iron pipe marked as shown) and Point Number 1067 (5/8" iron rod set in concrete) both found as described. Record Local Datum Plane Coordinates are as follows:

Pt. No. 1050	Northing	146265.183 Meters	RECORD	146265.183 Meters
	Easting	1269675.823 Meters		1269675.823 Meters
Pt. No. 1067	Northing	146195.331 Meters	RECORD	146195.342 Meters
	Easting	1269485.922 Meters		1269485.919 Meters

At point number 1037 as shown on the reference survey, I found a 5/8" iron rod with no cap, set at the following Local Datum Plane Coordinates:

Northing	146196.783 Meters	RECORD	146196.787 Meters
Easting	1269650.052 Meters		1269650.046 Meters

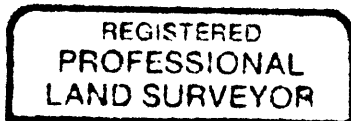

Mark A. Heimbürger
 OREGON
 JUL 18 1997
 MARK A. HEIMBURGER
 2287
Expires 6-30-03

FILED

Date: 3/5/2003 By: JP
 This survey consists of:
 FOR Map: ST. HWY I5-013 A
 Name: _____
 Corner Rpt: _____

DOUGLAS COUNTY
 SURVEYOR

C.S. File No 65/46-4