

FILED

Date: 8-19-2003 By: JC

This survey consists of:

Map: _____

Name: _____

Corner Rpt: 65/48-1

CORNER REPORT FORM

Section 10 _____ Township 24 _____ Range 7 _____

Douglas County Date July 31, 2003

CORNER DESIGNATION
only

Condition Report

Not Found

Renewed

Unrecorded

Surveyed In

Referenced out

DOUGLAS COUNTY
SURVEYOR

South 1/4 corner section 10

Previous Renewals/Surveys, etc:

Monument(s) & Accessories Found: (Condition and Source)

3 1/4" Alum. Cap

6" D. Fir BT, S 6°W 18.2', Dbl blaze, scribe vis., tag

12" D. Fir BT, N 36°E 39.5', Dbl blaze, scribe vis., tag

21" D. Fir BT, N 73°E 21.1', Dbl blaze, scribe vis., tag

33" D. Fir BT, S 78°E 6.1', scar vis., tag

All by Roberts in 1996

Fd. 3/4" I. Pipe, S 71°E 4.27' at base of 33" D. Fir - No record

Monument Detail

Sketch

Monument Set (Procedures and Description)

None

New Accessories


None

Location & Comments

Surveyor's Seal



Carl Sweeden

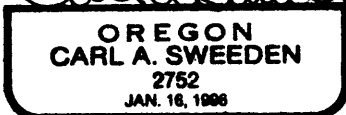

Exp. 6/30/04

Compass Declination

Firm/Agency: Sweeden Land Surveying

Address: 5211 Cole Road, Oakland, OR. 97462

Party Chief: C. Sweeden

Notes:

Witness: E. Wilds

440500

C.S. File No 65/48-1