

FILED

Date: 8-19-2003 By: X

This survey consists of:

Map: _____

Narrative: _____

Corner Rpt: 65/48-2

CORNER REPORT FORM

Section 10 _____ Township 24 _____ Range 7 _____

Douglas County Date July 31, 2003

CORNER DESIGNATION

only

Southwest corner section 10

Previous Renewals/Surveys, etc:

Monument(s) & Accessories Found: (Condition and Source)

- 2 1/2" Brass Cap (1956 DCSO)
- Cedar snag BT, S89°W 24.0' to root hole, rotting (DCSO 1956)
- 24" W. Fir BT, North 33.8', Scar vis., tag (DCSO 1956)
- 24" W. Fir BT, N 40°E 34.0', Scar vis., tag (DCSO 1956)
- 8" W. Fir BT, S 63°W 24.3', to root hole, laying down, tag (Shaner 1996)
- 15" D. Fir BT, S 32°E 30.3', scibe vis., tag (Shaner 1996)
- Reset 6' "T" post 1.0' east

Monument Detail

Sketch

Monument Set (Procedures and Description)


None

New Accessories

16" W. Fir BT, S 76°W 34.70', scribed "NE S 16 BT", tag

Location & Comments

Surveyor's Seal

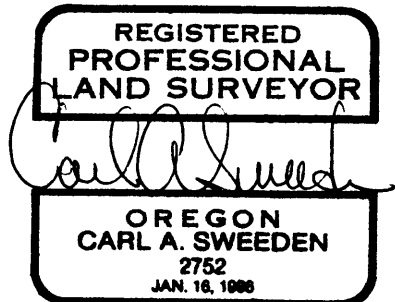

Compass Declination
Firm/Agency: Sweeden Land Surveying

Address: 5211 Cole Road, Oakland, OR. 97462

Party Chief: C. Sweeden

Notes:

Witness: E. Wilds

C.S. File No 65/48-2

400500