

FILED

Date: 8/21/2003 By: J

This survey consists of:

Map: _____

Name: _____

Corner Ept: 65/48-4

OREGON CORNER RESTORATION FORM

Section 8 Township 31S Range 4W

County DOUGLAS Date 8.5.03

DOUGLAS COUNTY SURVEYOR

Corner Designation

300540
E 1/4 SECTION 8

- Condition Report Only
- Not Found
- Renewed
- Unrecorded
- Surveyed In
- Referenced Out


Previous Renewals/Surveys, etc. _____

Monument(s) & Accessories Found: (Condition and Source)

- 1966 D.C.S.O I.P.B.C. WEST 198 GOOD
- 19" FIR N10W 40 HEALED
- 22" FIR S71W 132 HEALED
- 34" FIR STUMP N53 1/2 W 92
- 47" FIR S42 3/4 E 152 HEALED
- 28" CORNER TREE

Monument Detail

Sketch

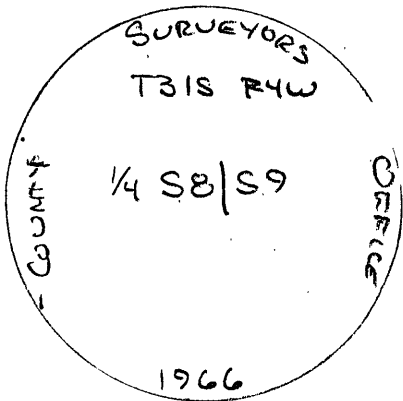

Monument Set (Procedures and Description)

New Accessories

Location & Comments

Compass Declination 19 1/2°
 Firm/Agency Roseburg Forest Products
 Address PO Box 1088
Roseburg Oregon 97470
 Party Chief Bill Olson
 Notes _____
 Witness Mike Fromdahl

Surveyor's Seal



RENEWS 6/30/04

C.S. File No 65/48-4