

FILED

Date: 8/21/2003 By: J

This survey consists of:

Map: _____

Name: _____

Corner No: 68/48-5

DOUGLAS COUNTY
SURVEYOR

OREGON CORNER RESTORATION FORM

Section 8 Township 31S Range 4W

County DOUGLAS Date 8-5-03

Corner Designation

240600

$\frac{1}{4} \frac{5}{8}$

- Condition Report Only
- Not Found
- Renewed
- Unrecorded
- Surveyed In
- Referenced Out

Previous Renewals/Surveys, etc. _____


Monument(s) & Accessories Found: (Condition and Source)

1966 D.C.S.O. I.P.B.C.

13" CEDAR N51E 6.3'

46" FIR S56 1/2 W 24.3' OPEN BLAZE NO SCRIBE

Monument Detail

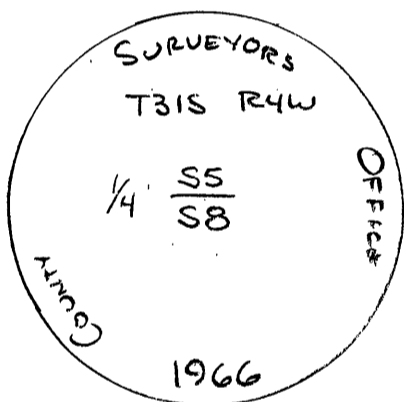

Sketch

Monument Set (Procedures and Description)

New Accessories

6" FIR N35W 17.7' SCRIBED "1/4S BT"

7" FIR S86E 17.6' SCRIBED "1/4S' BT"

Location & Comments

Compass Declination 19 1/2°

Firm/Agency Roseburg Forest

Products 1

Address P.O. Box 1088

Roseburg Oregon 97470

Party Chief Bill Olson

Notes _____

Witness Mike Fromdahl

Surveyor's Seal



RENEWS 6/30/04

C.S. File No 65/48-5