

FILED

Date: SEP 4 2003 By: JC

This survey consists of:

Map: _____

Name: _____

Corner Rpt: 65/48-7

OREGON CORNER RESTORATION FORM

Section 34 Township 25S Range 2W

County DOUGLAS Date JUNE 2003

DOUGLAS COUNTY SURVEYOR

Corner Designation

S 1/4 33 | 34

- Condition Report Only
- Not Found
- Renewed
- Unrecorded
- Surveyed In
- Referenced Out

Previous Renewals/Surveys, etc. _____

Monument(s) & Accessories Found: (Condition and Source)

1974 BLM STEEL PIPE AND BRASS CAP

RT: 15" FIR NB1E 19.1' HEALED

15" FIR N48 1/4 W 18.8' HEALED

B.O. 3/8" IRON ROD S1E 11.88'

RT: FOR B.O.

16" FIR N35E 1.3' HEALED

27" FIR S44W 16.5' HEALED

Monument Detail

Sketch




Monument Set (Procedures and Description)

New Accessories

Location & Comments

Compass Declination 20
 Firm/Agency Roseburg Forest Products
 Address PO Box 1088
Roseburg Oregon 97470
 Party Chief Bill Olson
 Notes _____
 Witness Mike Fromdahl

Surveyor's Seal

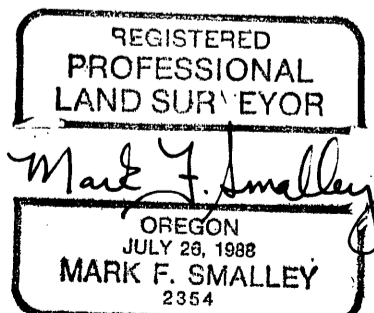

RENEWS 6/30/04

C.S. File No 65/48-7