

FILED

Date: SEP 4 2003 By: JC

This survey consists of:

Map _____
Name _____
Corner Rpt: 65/48-8

OREGON CORNER RESTORATION FORM

Section 3 Township 26S Range 2W

County DOUGLAS Date JUNE 2003

DOUGLAS COUNTY
SURVEYOR

Corner Designation

NE Cor Sec 4
400700


- Condition Report Only
- Not Found
- Renewed
- Unrecorded
- Surveyed In
- Referenced Out

Previous Renewals/Surveys, etc. _____

Monument(s) & Accessories Found: (Condition and Source)

- BLM STEEL PIPE AND BRASS CAP & STONE
- RTs: 50" FIR S16 3/4 E 337.9' CHOPPED OUT - ROTTING (ORIGINAL)
- 20" FIR S23 1/4 W 263.3' GONE (NO STUMP)
- 24" ROTTED FIRE STUMP S14 1/4 W 35.3'
- 19" FIR S55 E 13.2' SCRIBE VISIBLE

Monument Detail

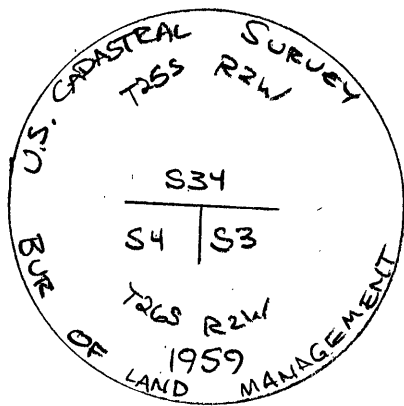

Sketch

Monument Set (Procedures and Description)

New Accessories

- RTs: 25" FIR S16 E 39.7' SCRIBED "S3 BT"
- 13" FIR N2E 9.6' SCRIBED "CC BT"

Location & Comments

Compass Declination 20
 Firm/Agency Roseburg Forest PRODUCTS
 Address PO Box 1088
Roseburg Oregon 97470
 Party Chief Bill Olson
 Notes _____
 Witness Mike Fromdahl

Surveyor's Seal



RENEWS 6/30/04

C.S. File No 65/48-8