

FILED

Date: SEP 4 2003 By: JC

This survey consists of:

Map: _____

Name: _____

Corner Fpt: 65/48-9

DOUGLAS COUNTY SURVEYOR

OREGON CORNER RESTORATION FORM

Section 34 Township 25S Range 2W

County DOUGLAS Date JUNE 2003

Corner Designation

SECTION CORNER 633/S34
400100 S4

- Condition Report Only
- Not Found
- Renewed
- Unrecorded
- Surveyed In
- Referenced Out

Previous Renewals/Surveys, etc. _____

Monument(s) & Accessories Found: (Condition and Source)

BLM STEEL PIPE AND BRASS CAP

BTS: 22" FIR N42³/₄E 11.2' HEALED

22" FIR N40W 33.0' HEALED


FOUND 1/2" I.D. I.P. BOLT WITH 1" BC MARKED "PROPERTY CORNER"
96.63' NORTH ALONG LINE

BTS: 26" FIR N12E 17⁴' HEALED

16" FIR N15W 10⁵' DOWN HEALED

Monument Detail

Sketch

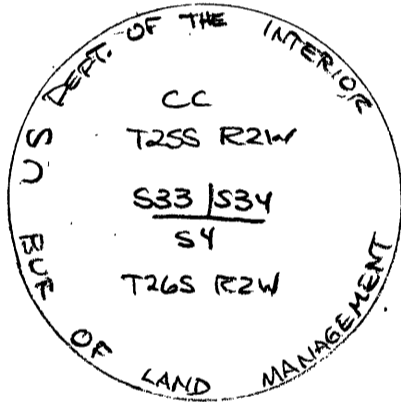

Monument Set (Procedures and Description)

New Accessories

Location & Comments

Compass Declination 20

Firm/Agency Roseburg Forest

Products _____

Address PO Box 1088


Roseburg Oregon 97470

Party Chief Bill Olson

Notes _____

Witness Mike Froudahl

Surveyor's Seal

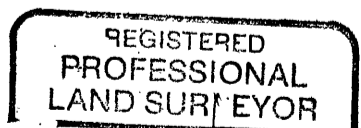

Mark F. Smalley
 OREGON
 JULY 26, 1988
 MARK F. SMALLEY
 2354
 RENEWS 6/30/04

C.S. File No 65/48-9