

FILED

Date: SEP 4 2003 By: JC
This survey consists of:

Map: _____
Name: _____
Corner Rpt: 65/48-10

DOUGLAS COUNTY
SURVEYOR

OREGON CORNER RESTORATION FORM

Section 11 Township 25S Range 2W

County DOUGLAS Date MAY 2003

Corner Designation

C 1/4


- Condition Report Only
- Not Found
- Renewed
- Unrecorded
- Surveyed In
- Referenced Out

Previous Renewals/Surveys, etc. #143

Monument(s) & Accessories Found: (Condition and Source)
1995 IRON PIPE AND BRASS CAP (RPLS 811)

BTs: 14" FIR N4°38'W 82.1' HEALED BLAZE
13" FIR S78'W 14.9' HEALED BLAZE
12" FIR S8°16'W 22.9' HEALED BLAZE
12" FIR S39°08'E 31.5' HEALED BLAZE

Monument Detail

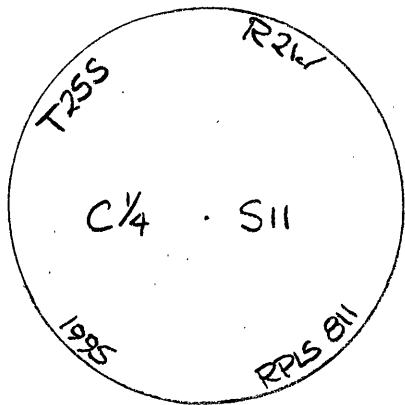

Sketch

Monument Set (Procedures and Description)

New Accessories

Location & Comments

BLAZED, PAINTED LINES Compass Declination 20°
RUNNING SOUTH, WEST, Firm/Agency Roseburg Forest
AND EAST FROM CORNER PRODUCTS
 Address PO Box 1088
Roseburg Oregon 97470
 Party Chief Bill Olson
 Notes _____
 Witness MIKE FROMDALL

Surveyor's Seal

REGISTERED
PROFESSIONAL
LAND SURVEYOR

Mark F. Smalley
OREGON
JULY 28, 1988
MARK F. SMALLEY
2354

RENEWS 6/30/04

C.S. File No 65/48-10