

FILED

Date: 9-16-2003 By: JC

This survey consists of:

Map: _____

Name: _____

Corner Rpt: 65/48-12

OREGON CORNER RESTORATION FORM

Section 26 Township 26S Range 3W

County Douglas Date 8-28-03

DOUGLAS COUNTY
SURVEYOR

Corner Designation

S¹/₄ S26 S40200


- Condition Report Only
- Not Found
- Renewed
- Unrecorded
- Surveyed In
- Referenced Out

Previous Renewals/Surveys, etc. _____

Monument(s) & Accessories Found: (Condition and Source)

26" CEDAR NS3E 56^B HEALED (RECORD - 27")
22" CEDAR SB3E 20^S HEALED

Monument Detail

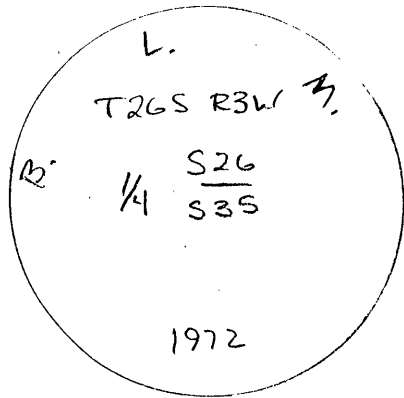

Sketch

Monument Set (Procedures and Description)

New Accessories


13" FIR SB0W 34^E SCRIBED "1/4 S BT"
12" PINE NS4W 24² SCRIBED "1/4 S BT"

Location & Comments

CORNER IS APPROX.
20" BELOW ROAD
SURFACE

Compass Declination 19 1/2
 Firm/Agency ROSEBURG
FOREST PRODUCTS
 Address P.O. Box 1088
ROSEBURG OREGON 97470
 Party Chief Bill Olson
 Notes _____
 Witness MIKE FRODHAL

Surveyor's Seal

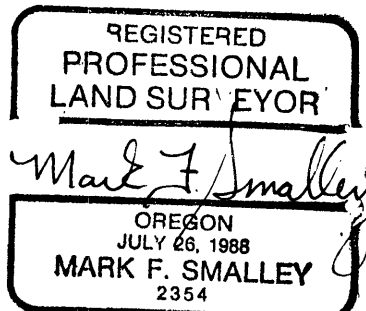

RENEWS 6/30/04
 C.S. File No 65/48-12