

FILED

Date: 9-16-2003 By: Jc

This survey consists of:

Map: \_\_\_\_\_

Name: \_\_\_\_\_

Corner Rpt: 65/48-13

DOUGLAS COUNTY  
SURVEYOR

OREGON CORNER RESTORATION FORM

Section 26 Township 26S Range 3W

County DOUGLAS Date 9-2-03

Corner Designation

C-S. 1/4

- Condition Report Only
- Not Found
- Renewed
- Unrecorded
- Surveyed In
- Referenced Out

Previous Renewals/Surveys, etc. \_\_\_\_\_

BLM pg. 15406

Monument(s) & Accessories Found: (Condition and Source)

BTS: 19" FIR S47W 25' HEALED

ROTTED FIR STUMP S22E 27' HEALED

Monument Detail

Sketch



Monument Set (Procedures and Description)

ALUMINUM CAP ON A 5/8" X 3/16" REBAR

New Accessories

BT: 14" FIR N62W SCRIBED "CS 1/4 BT"

Location & Comments

Compass Declination 19 1/2

Firm/Agency ROSEBURG

FOREST PRODUCTS

Address PO Box 1088


ROSEBURG OREGON 97470

Party Chief Bill Olson

Notes \_\_\_\_\_

Witness Mike Fromdahl

Surveyor's Seal

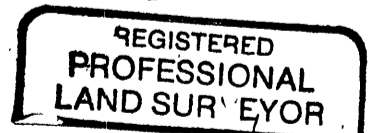

*Mark F. Smalley*  
 OREGON  
 JULY 26, 1988  
 MARK F. SMALLEY  
 2354

RENEW = 6/30/04

C.S. File No 65/48-13